


T.22S. R.6W. W.M.

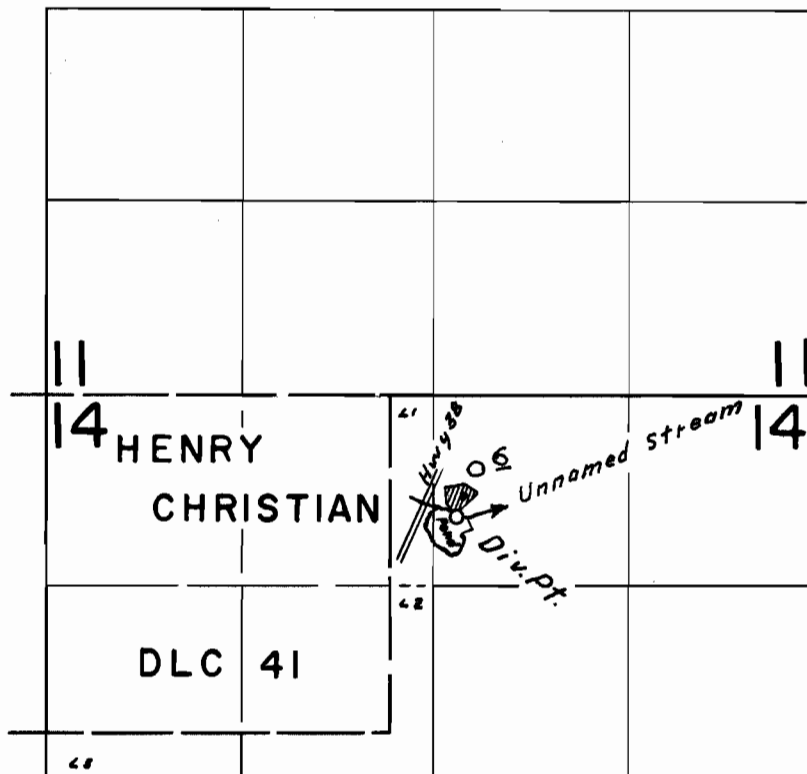

FINAL PROOF SURVEY
UNDER

R-37687 R-2991
Application No. 37493 Permit No. 28106
IN NAME OF

RAYMOND C. and NONA FLAGG

Surveyed Aug. 7, 1964, by *C. J. Gardner*