


T.22S. R.6W. W.M.

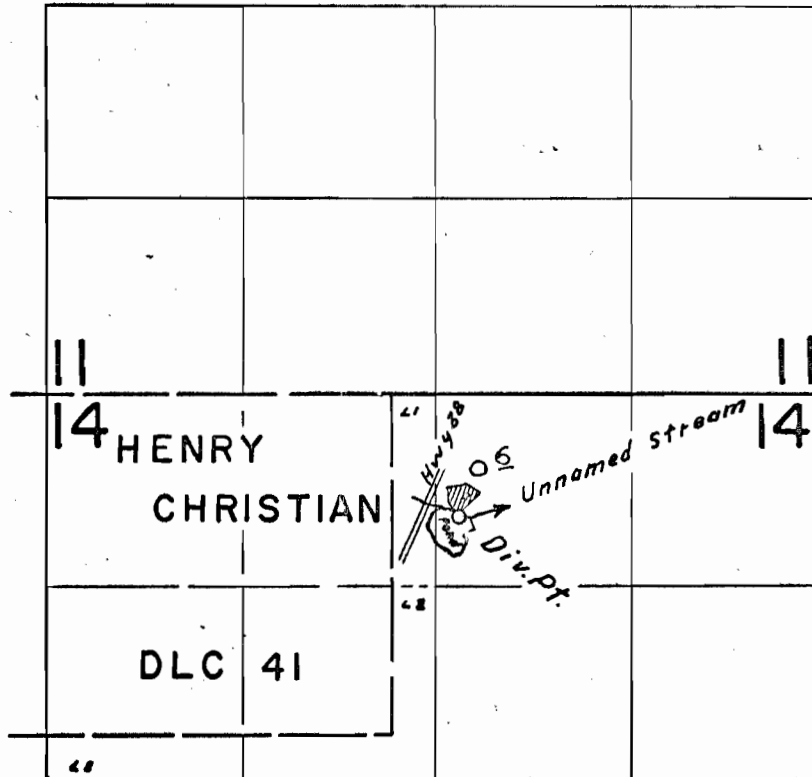

**FINAL PROOF SURVEY**  
UNDER

R-37687                      R-2991  
Application No. 37493    Permit No. 28106  
IN NAME OF

**RAYMOND C. and NONA FLAGG**

Surveyed Aug. 7, 1964, by *C. J. Gardner*.