


T.24S. R.7W. W.M.

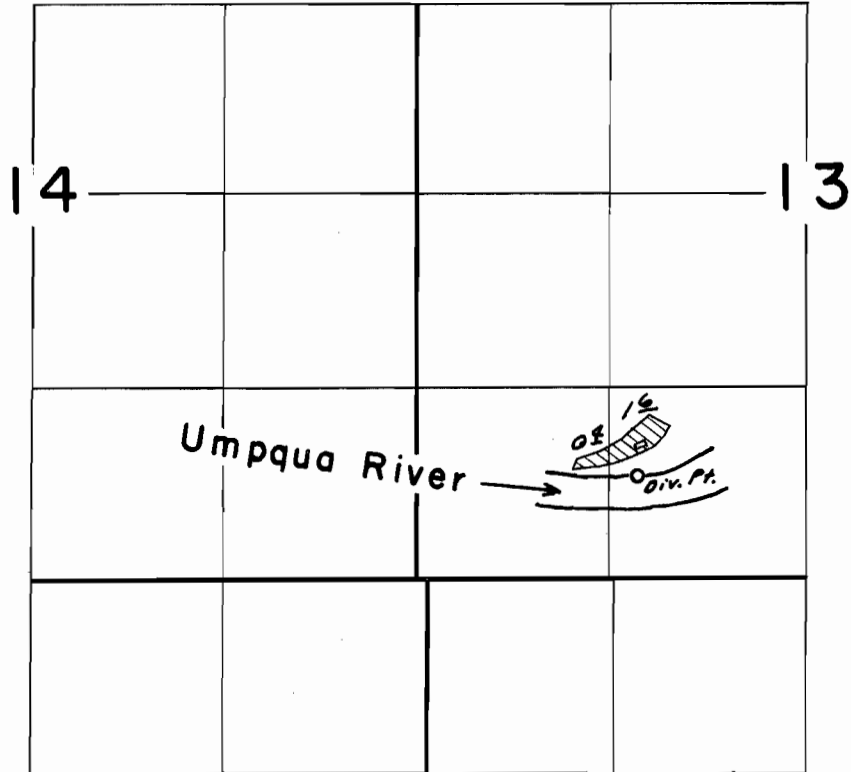

**FINAL PROOF SURVEY**  
UNDER

Application No. 37899 Permit No. 28367.

IN NAME OF

JAMES L. FLYNN

Surveyed July 10, 1964, by *C. J. Gardner*