


T.26S. R.4W. W.M.

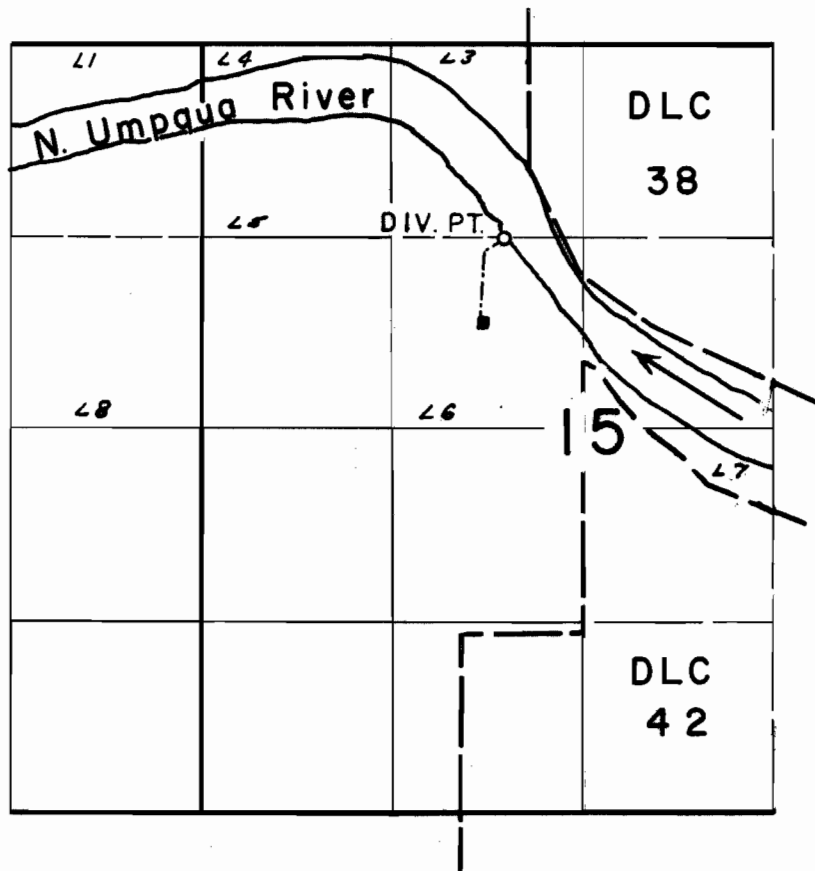

FINAL PROOF SURVEY
UNDER

Application No. 38226. Permit No. 28482
IN NAME OF

KENNETH E. & CRYSTAL M. DeSHAZER

Surveyed July 29, 1964, by *C.J. Gordon*