


T.27S. R.6&7 W. W.M.

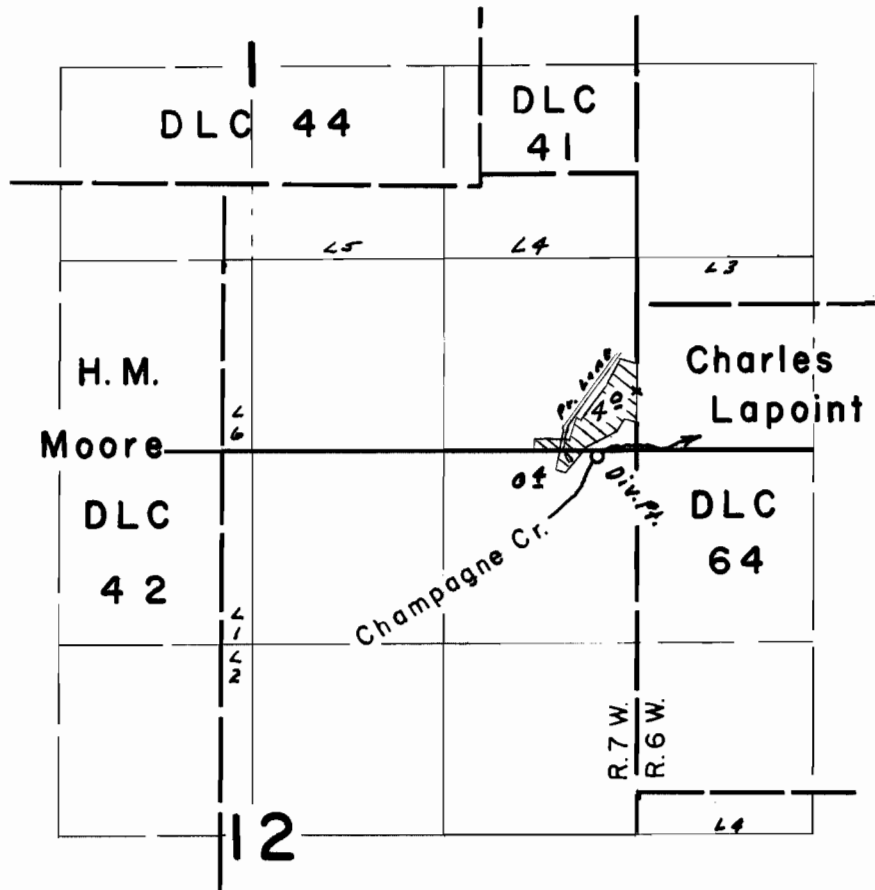

FINAL PROOF SURVEY UNDER

Application No. 38533 Permit No. 28673
IN NAME OF

HOWARD GRANT KAISER

Surveyed July 15, 1964, by C. J. [Signature]