


T.26S. R.3W. W.M.

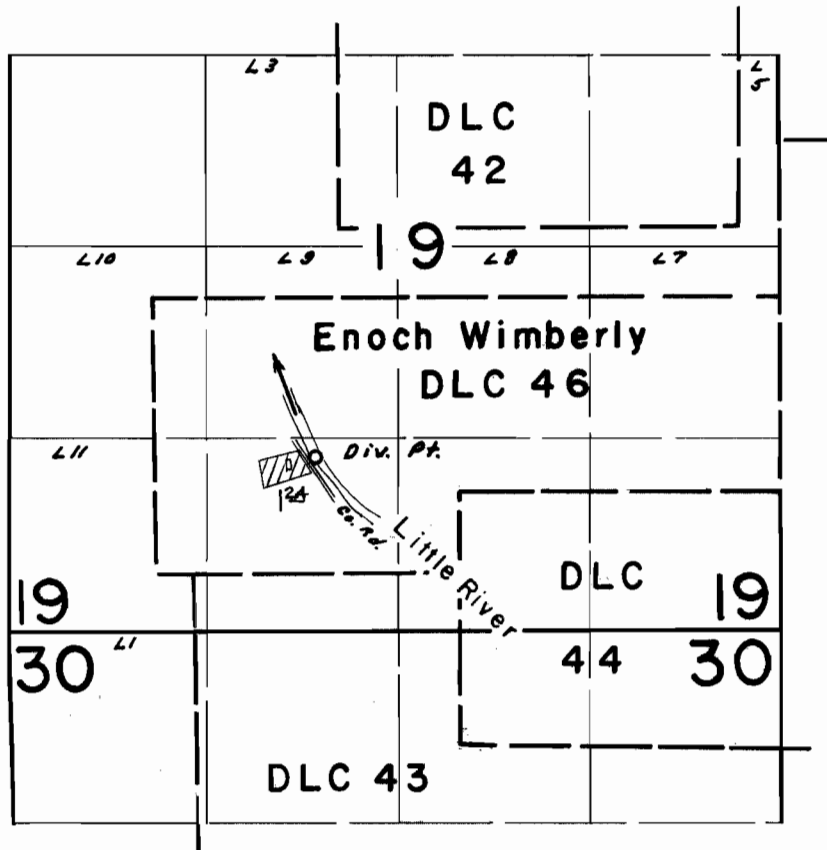

FINAL PROOF SURVEY
UNDER

Application No. 38662 Permit No. 28771
IN NAME OF

GUSTAF & LOIS I. SCHAEFER

Surveyed July 17, 1964, by C. J. Anderson