


T.27S. R.3 W. W.M.

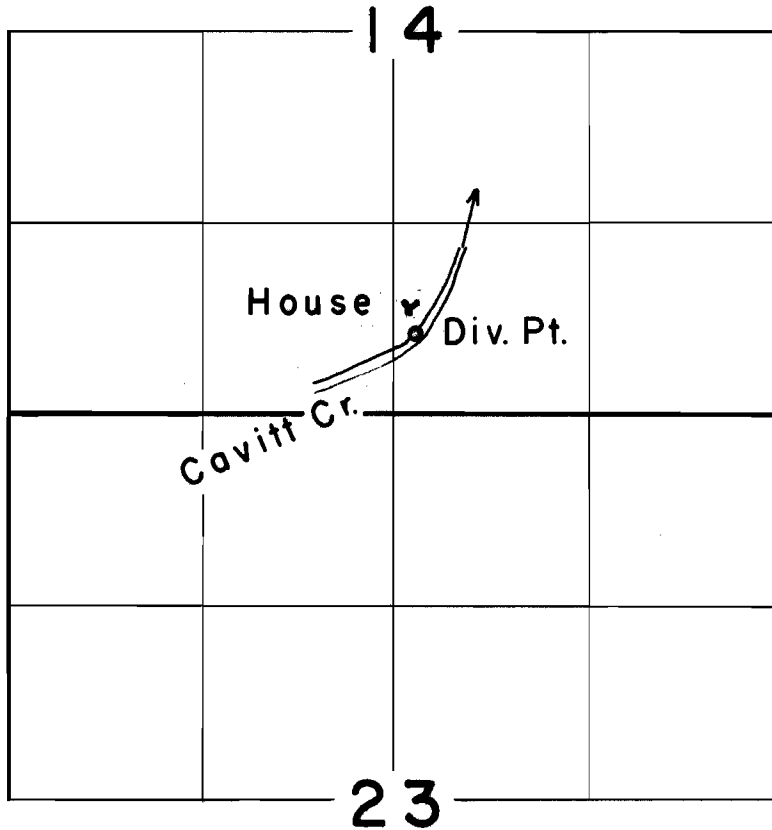

**FINAL PROOF SURVEY**  
UNDER

Application No. 39101 Permit No. 29108  
IN NAME OF

**ROY J. HEHN**

Surveyed July 16, 1964, by *C. J. Jordan*