


R922
52655

32654

T.35S.R.29E.W.M.

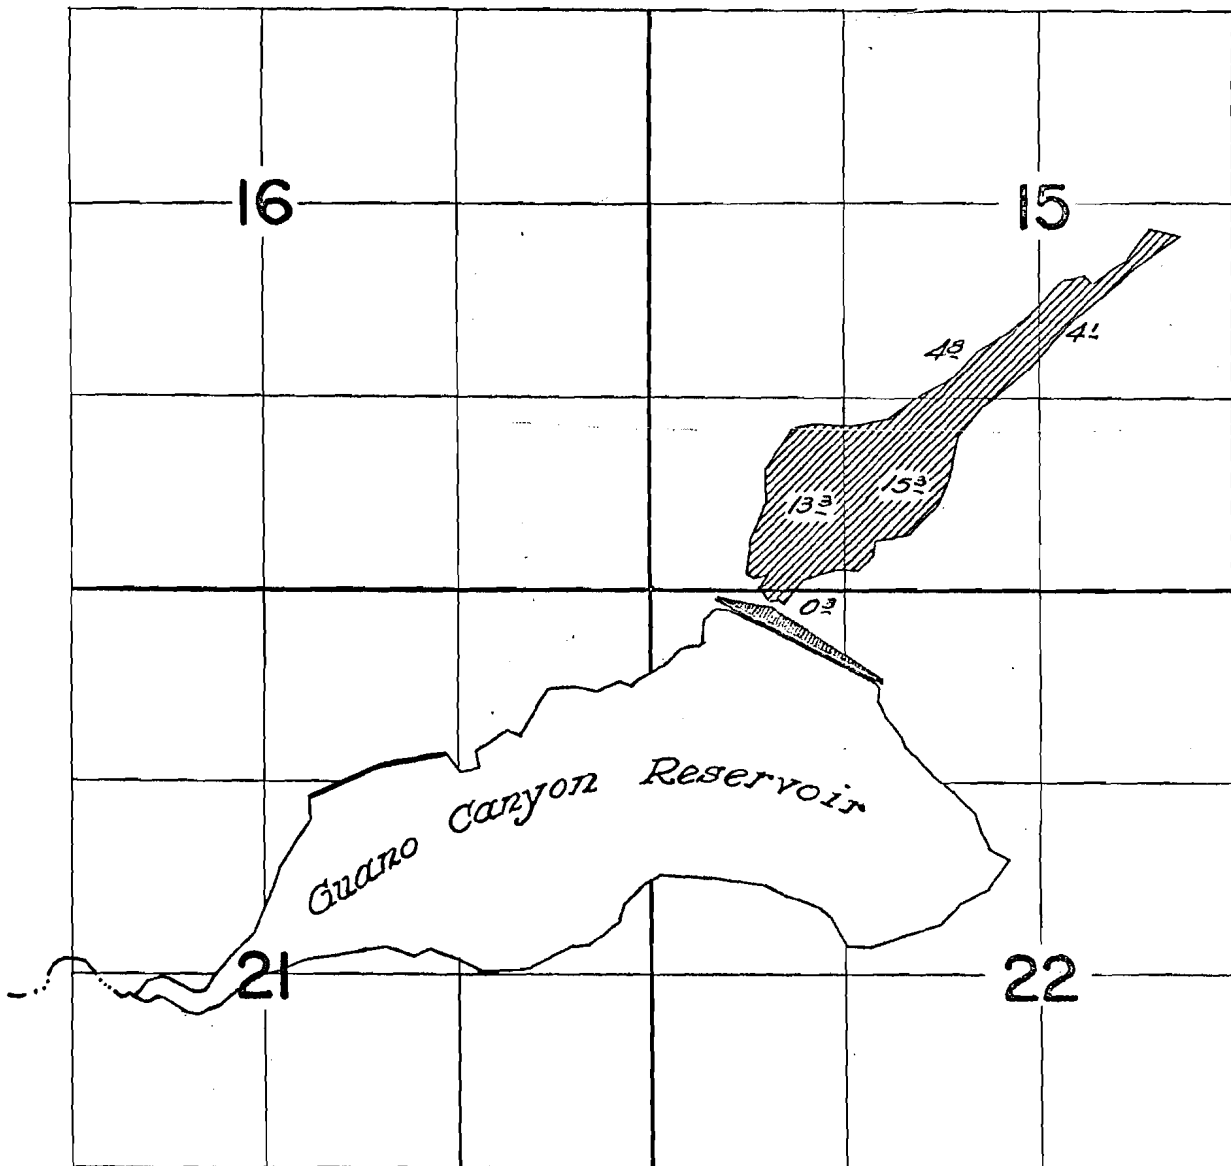

FINAL PROOF SURVEY
UNDER

R-22839 R-922
Application No. 22840 Permit No. 18047
IN NAME OF

CLARENCE S. MILLER

Surveyed Aug. 26 & 27 1963, by T. Lauer.....

35-29 ✓