


18047  
32655

T.35S.R.29E.W.M.

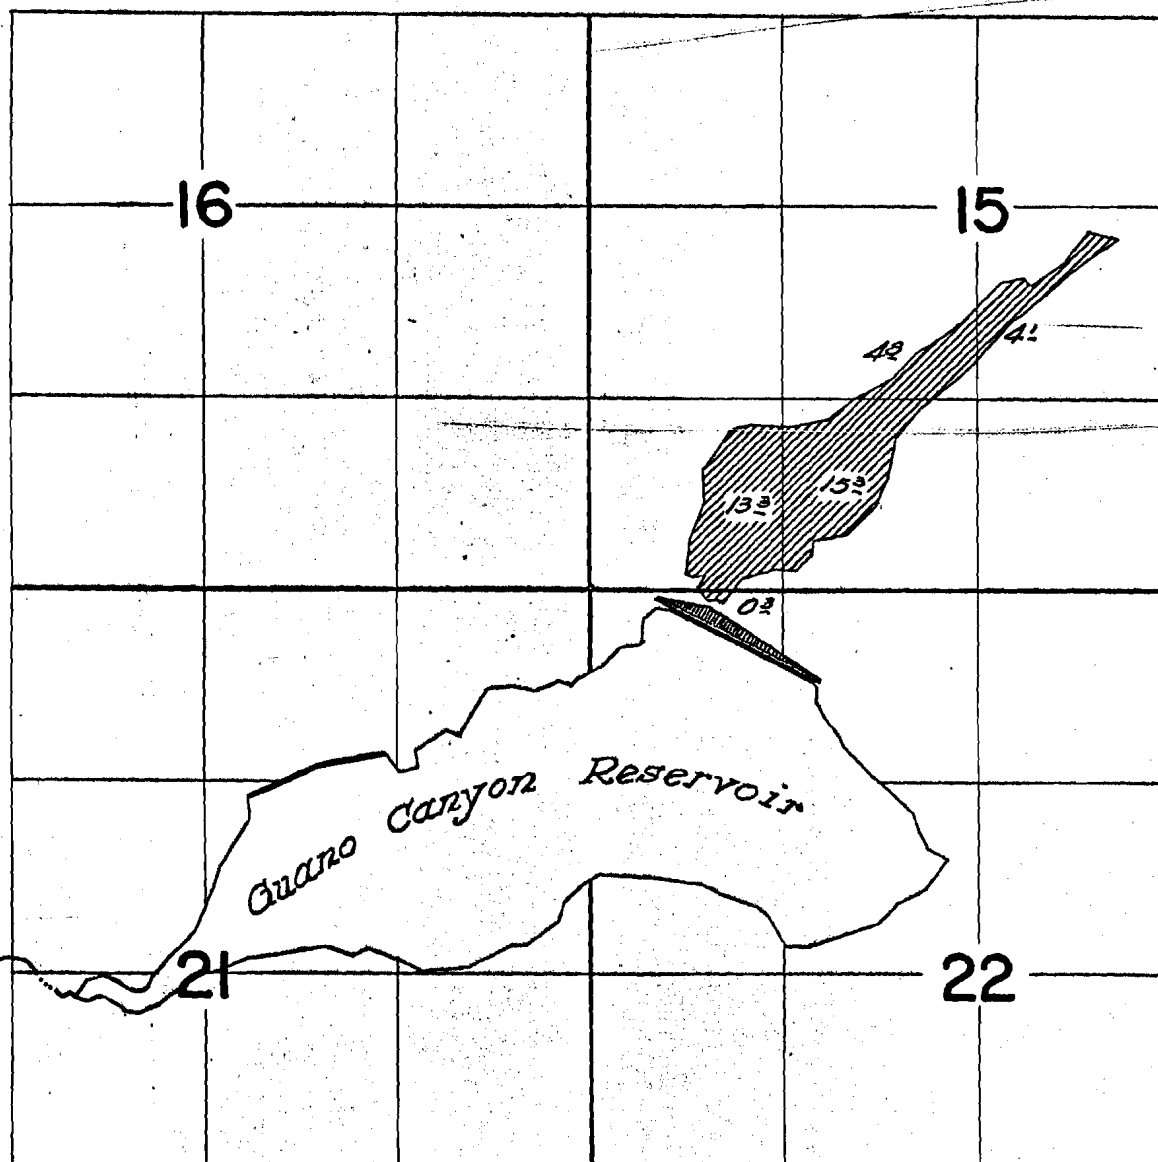

**FINAL PROOF SURVEY**  
UNDER

R-22839      R-922  
Application No. 22840      Permit No. 18047  
IN NAME OF

CLARENCE S. MILLER

Surveyed Aug. 26/27 1963, by T. Lower

35-29 ✓