


T. 4 | S. R. 8 W W M

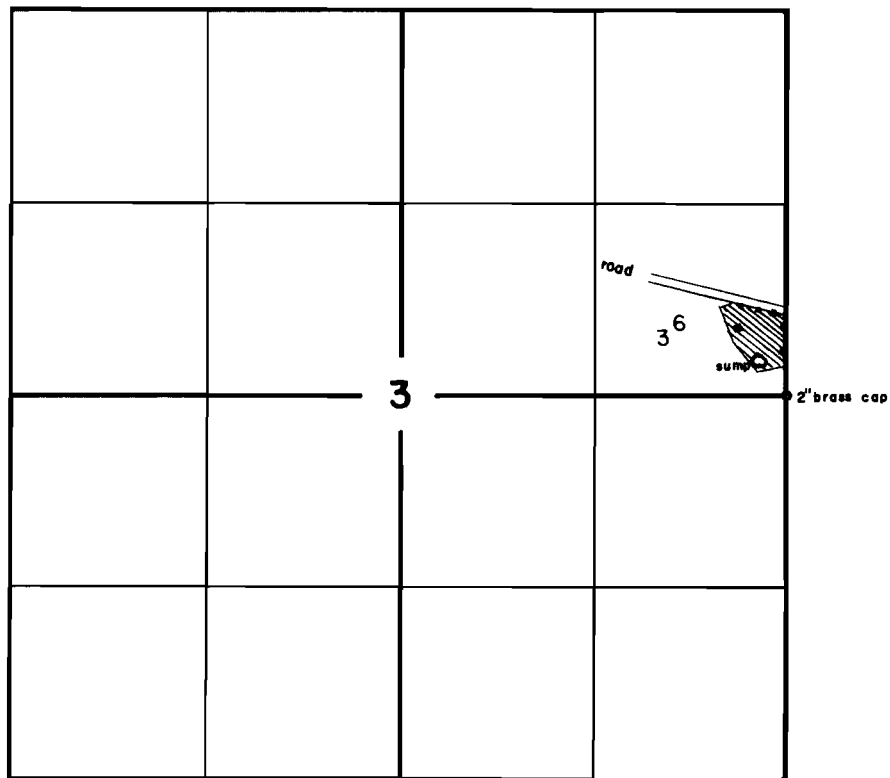

FINAL PROOF SURVEY UNDER

Application No. G-2301 Permit No. G-2121
IN NAME OF

.....VERNON M. JOHNSON.....

Surveyed Feb. 18... 1965, by R. B. STEIMER