


T. 36 S. R. 6 W. W. M.

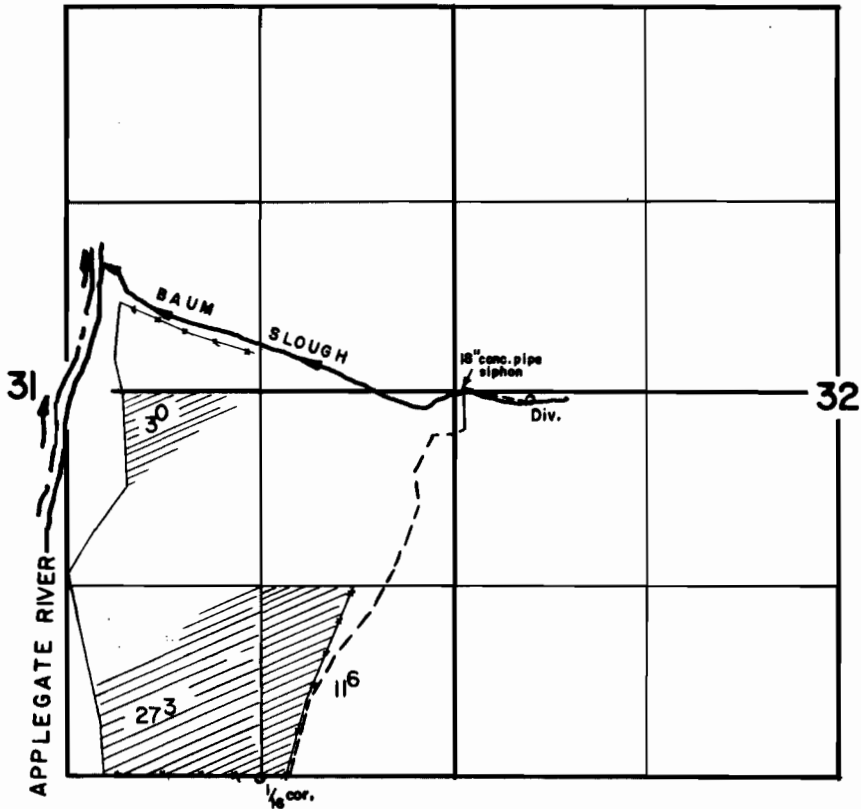

**FINAL PROOF SURVEY**  
UNDER

Application No. 32126... Permit No. 25390...  
IN NAME OF

.....**WM. F. SPRATLING**.....

Surveyed March 11, 1965, by R.B. Steimer....