


T. 36 S. R. 5 W. W.M.

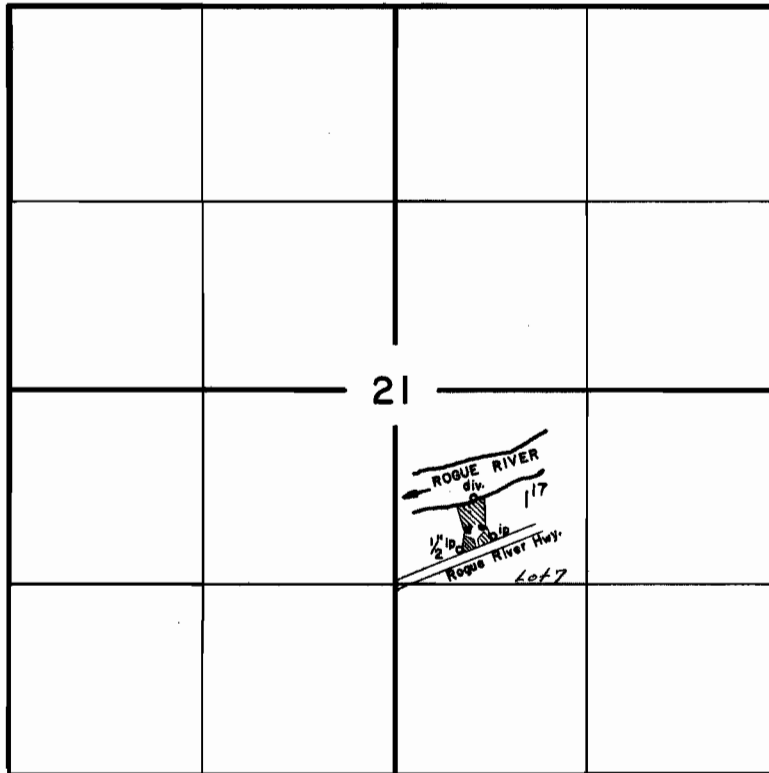

FINAL PROOF SURVEY
UNDER

Application No. 38467 Permit No. 28644
IN NAME OF

.....JOHN WILSON.....

Surveyed Feb 24 1965, by R.B. Steimer.....