


T.10S.R.8&9W.W.M.

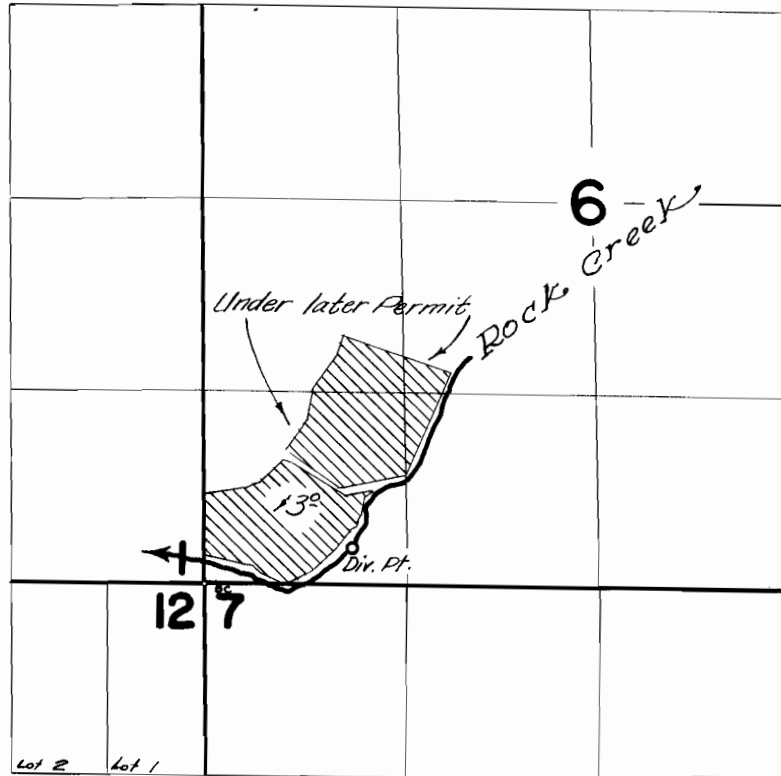

FINAL PROOF SURVEY UNDER

Application No. 30811..... Permit No. 24254 ..
IN NAME OF

..... SARA E. NILSEN

Surveyed June 26 1963, by C. Baker