


T.I.S.R.9W.W.M.

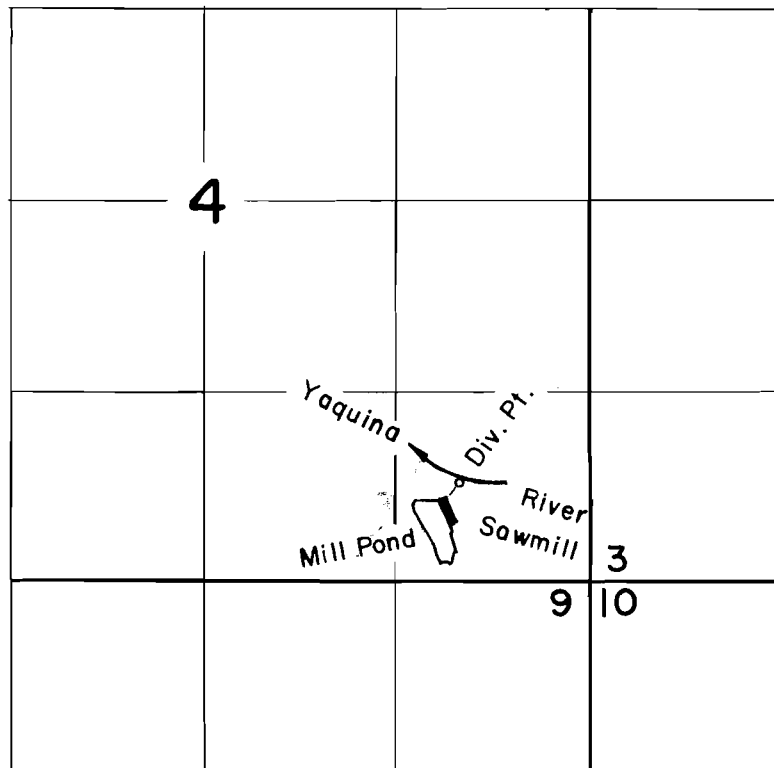

FINAL PROOF SURVEY
UNDER

R-33502 R-2323
Application No. 33457... Permit No. 26548...
IN NAME OF

W. O. W. Lumber Company Inc.

Surveyed Sept. 25, 1964, by F. Siegmund