


T.II S.R.IIW.W.M.

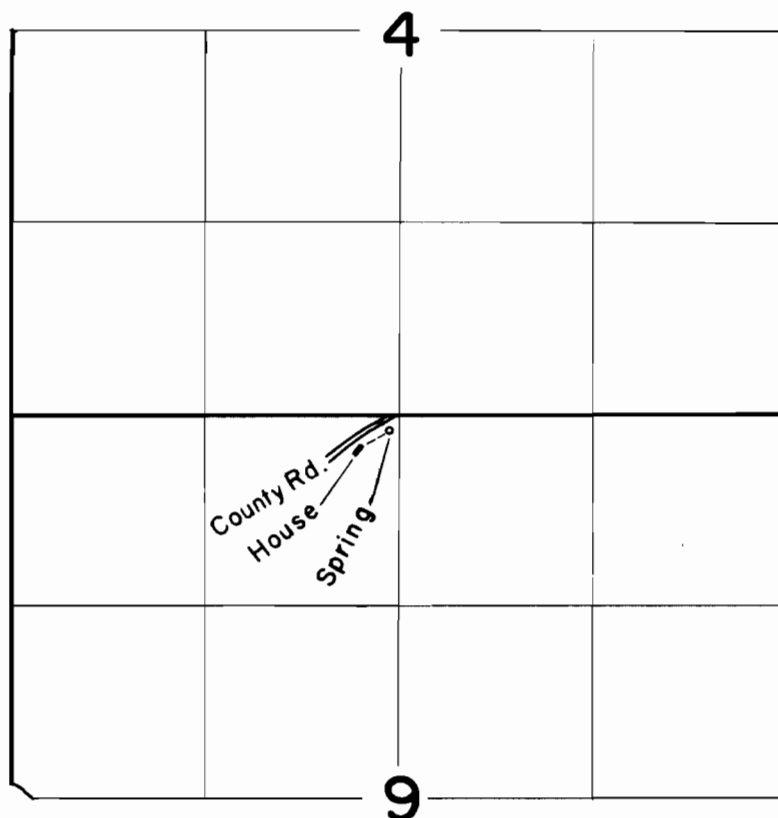

FINAL PROOF SURVEY
UNDER

Application No. 34031 Permit No. 26837
IN NAME OF

Ira E. Craft

Surveyed Sept. 23, 1964, by F. Siegmund