


T. 11 S. R. 2 W. W.M.

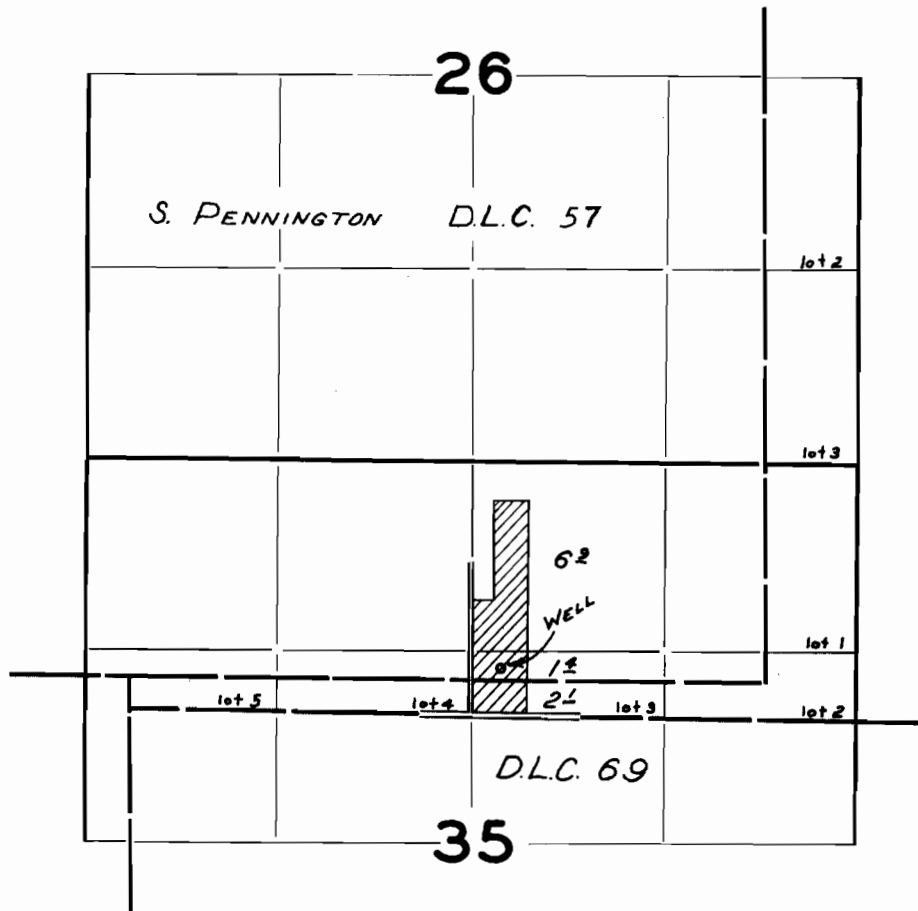

**FINAL PROOF SURVEY**  
UNDER

Application No. G-2315 Permit No. G-2141  
IN NAME OF

ALFRED E NOFZIGER

Surveyed SEP 5 1963, by C. BAKER