


T.14 S.R.3 W.W.M.

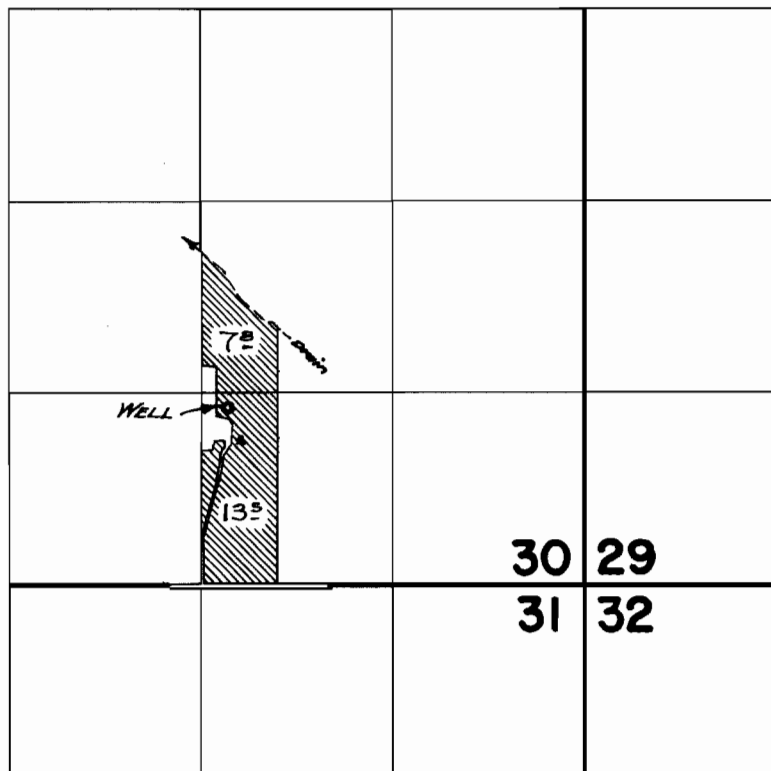

**FINAL PROOF SURVEY**  
UNDER

Application No. G-2417. Permit No. G-2258.  
IN NAME OF

ARTHUR W. & MARIANNA F. ULRICH

Surveyed October 14, 1964, by *R. J. Peterson*