


T. 15 S. R. 3 W. W. M.

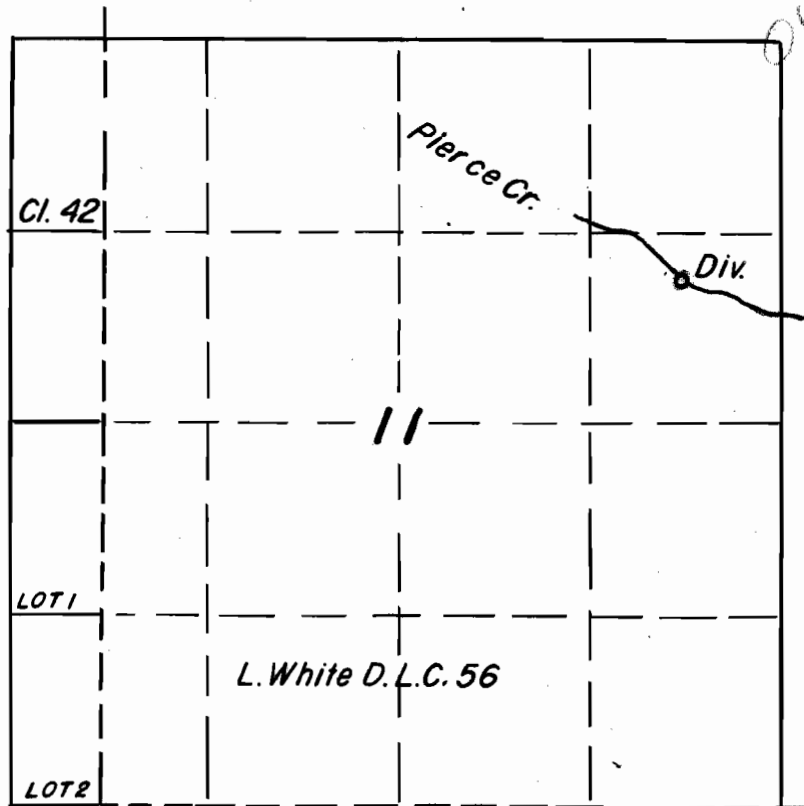

**FINAL PROOF SURVEY
UNDER**

Application No. 33105 Permit No. 26169
IN NAME OF

P.G. & Madaleine Lynch

Surveyed Oct. 28 1964, by F. Siegmund