


T. 10 S. R. 2 W. W. M.

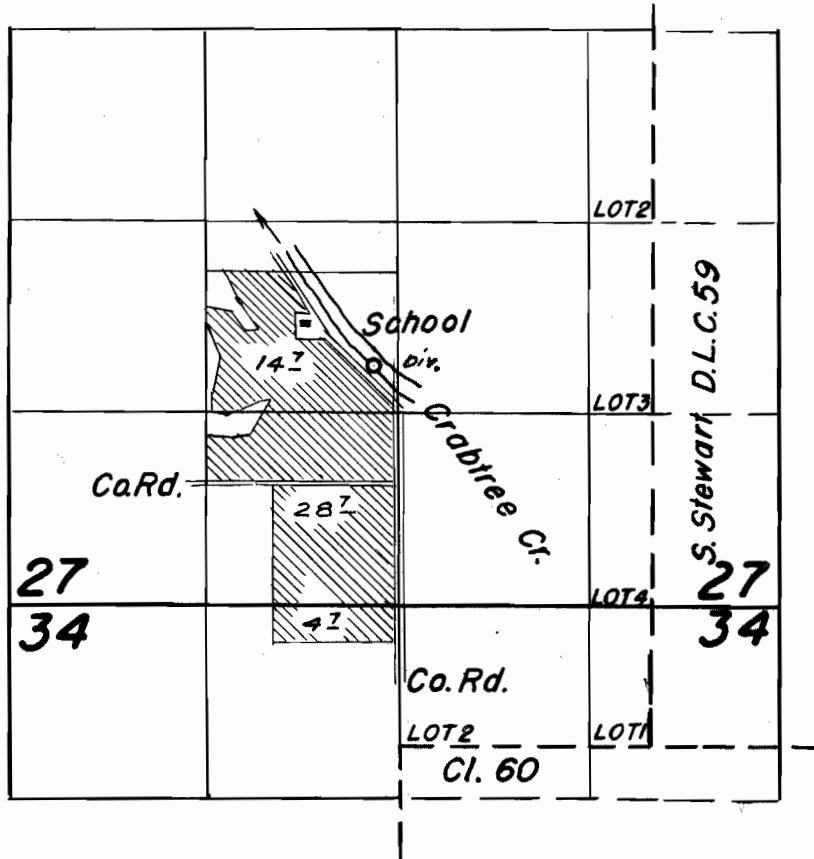

FINAL PROOF SURVEY
UNDER

Application No. 3370/Permit No. 26637
IN NAME OF

Bose Brothers

Surveyed Oct. 2 1964, by F. Siegmund