


T.I.S.R.I.W.W.M.

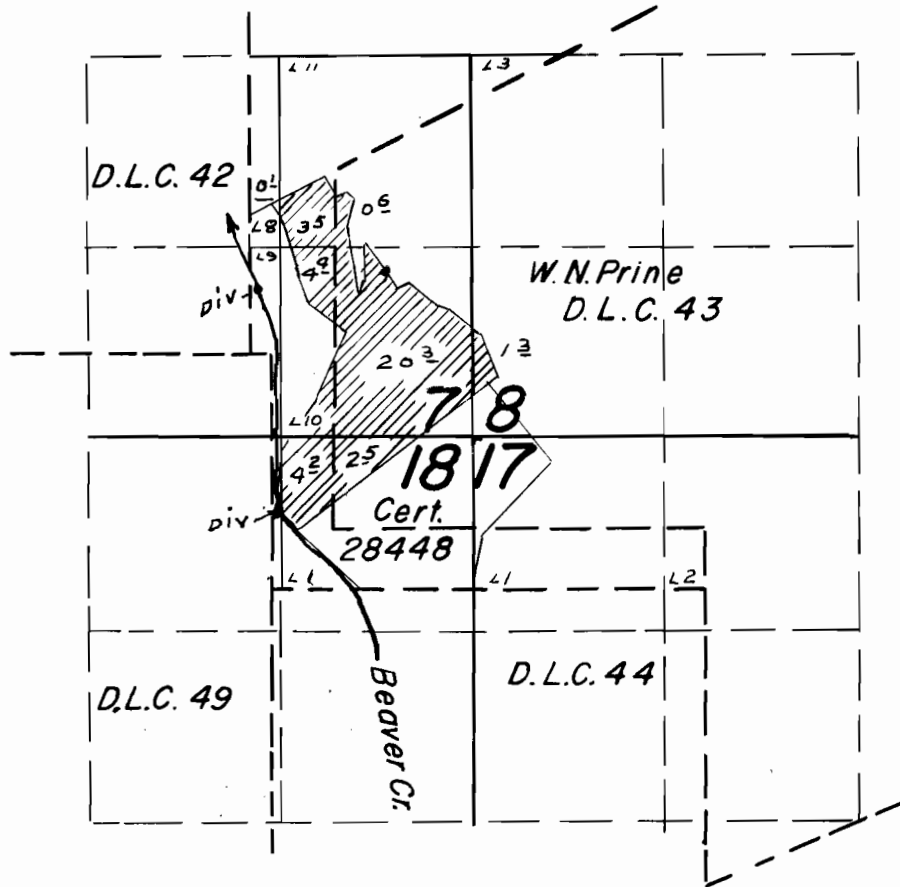

FINAL PROOF SURVEY
UNDER

Application No. 34552 Permit No. 27131...
IN NAME OF

Lee & Everett Ulm

Surveyed Oct 30 1964, by F. Siegmund