


T. 10 S. R. 1 W. W. M.

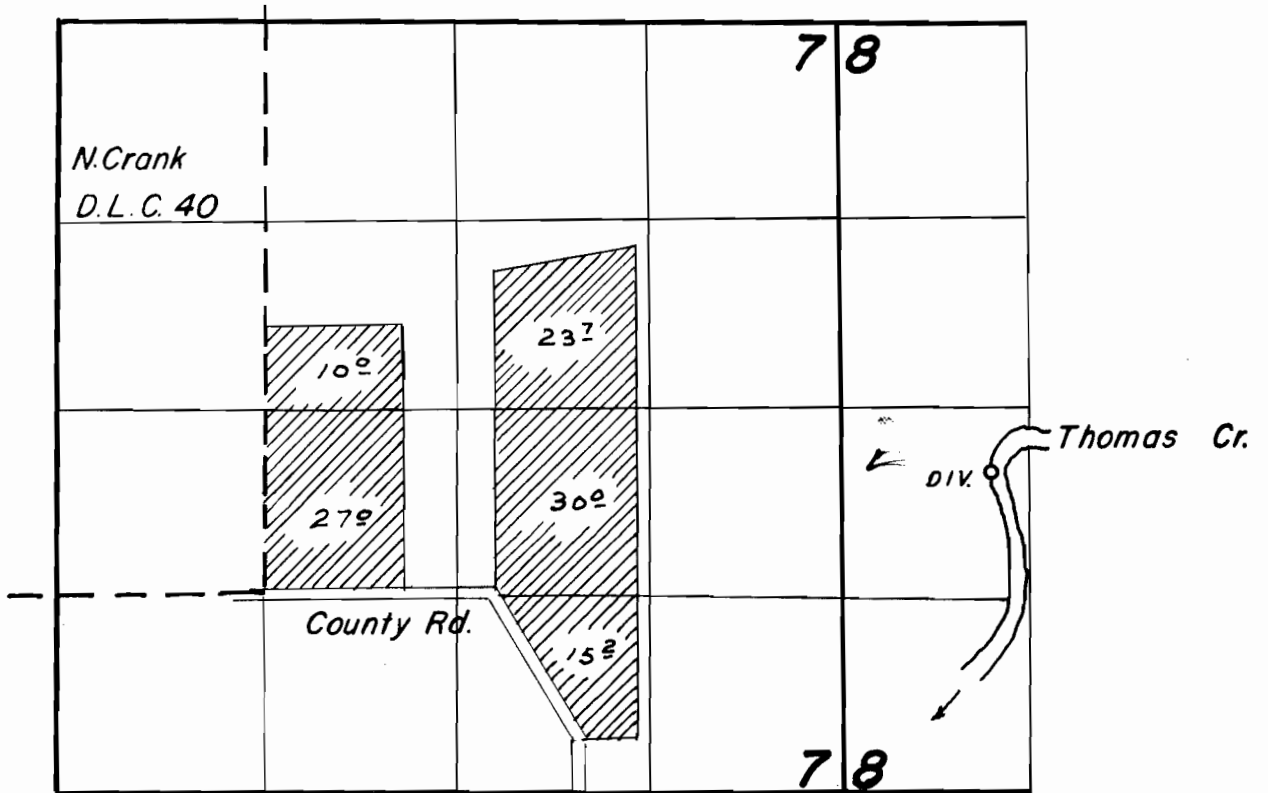

FINAL PROOF SURVEY
UNDER

Application No. 37391 Permit No. 27832
IN NAME OF

John Anderson Cox

Surveyed Oct 30 1964, by F. Siegmund