


T.18S.R.41E.W.M.

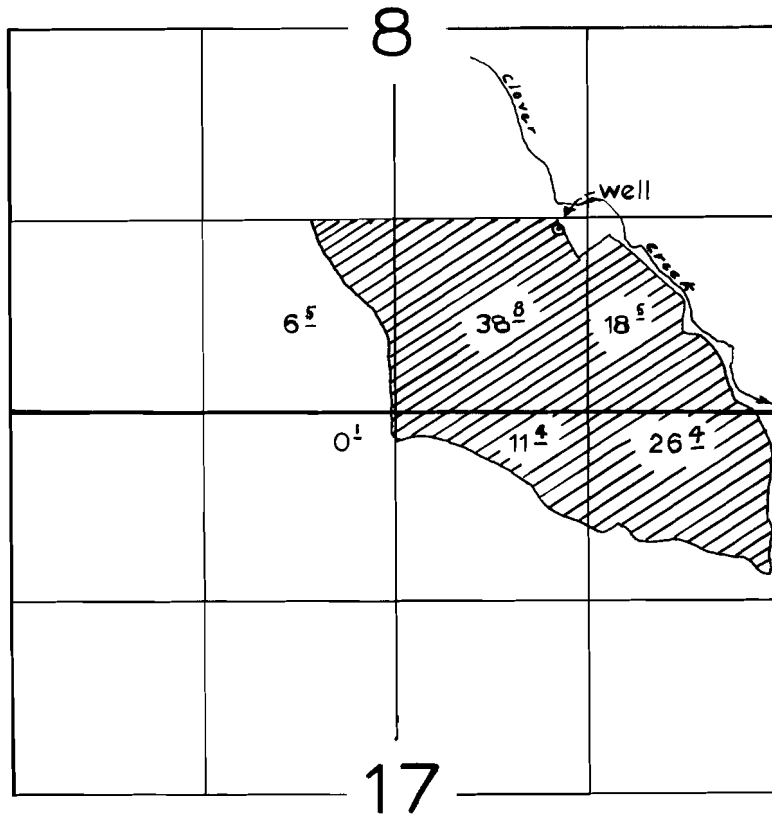

FINAL PROOF SURVEY
UNDER

Application No. G-1612 Permit No. G-1482
IN NAME OF

ROY C. STEWART

Surveyed Oct. 9, 1964, by E.W. Elfering