


T.14S.R.39E.W.M.

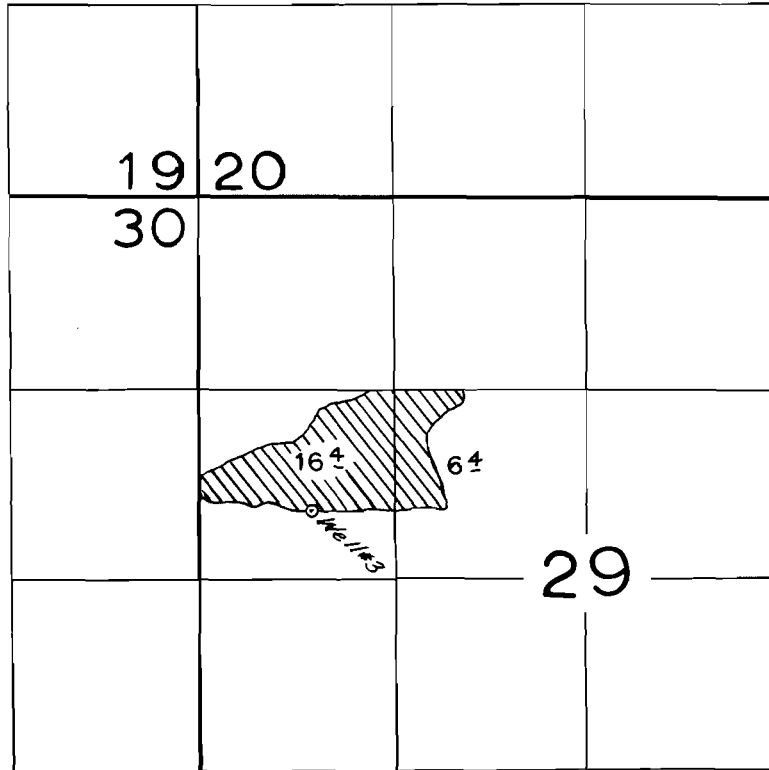

**FINAL PROOF SURVEY**  
UNDER

Application No. G-1624... Permit No. G-1492...  
IN NAME OF

**JOHN MOLTHAN**

Surveyed NOV. 6... 1964, by *F.W. Elfering*