


T.15S.R.47E.W.M.

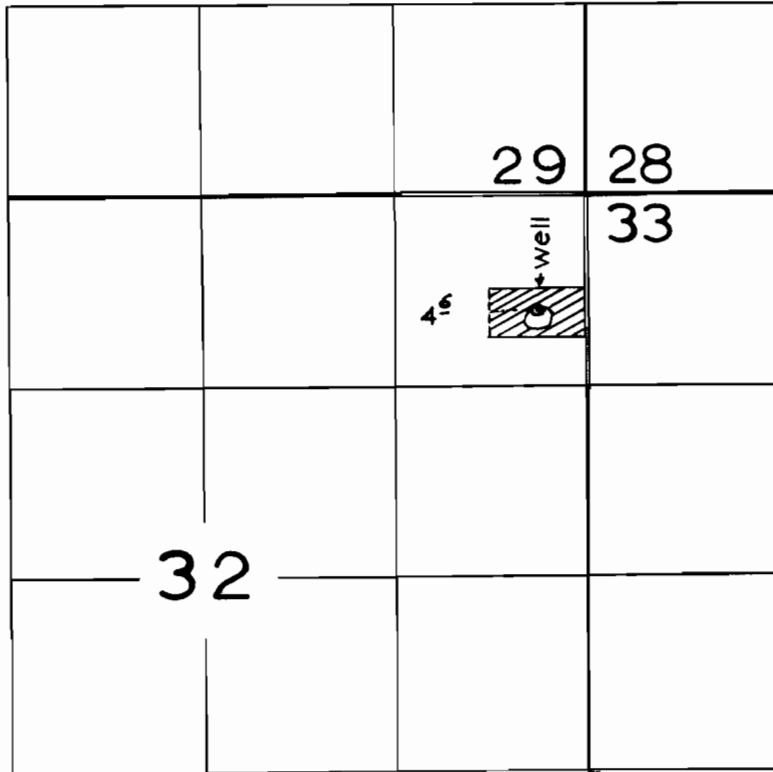

FINAL PROOF SURVEY
UNDER

Application No. G-1696... Permit No. G-1556...
IN NAME OF

ALFRED L. BLOCHER

Surveyed OCT. 8... 1964., by *F.W. Estering*.....