


T.17S.R.47E.W.M.

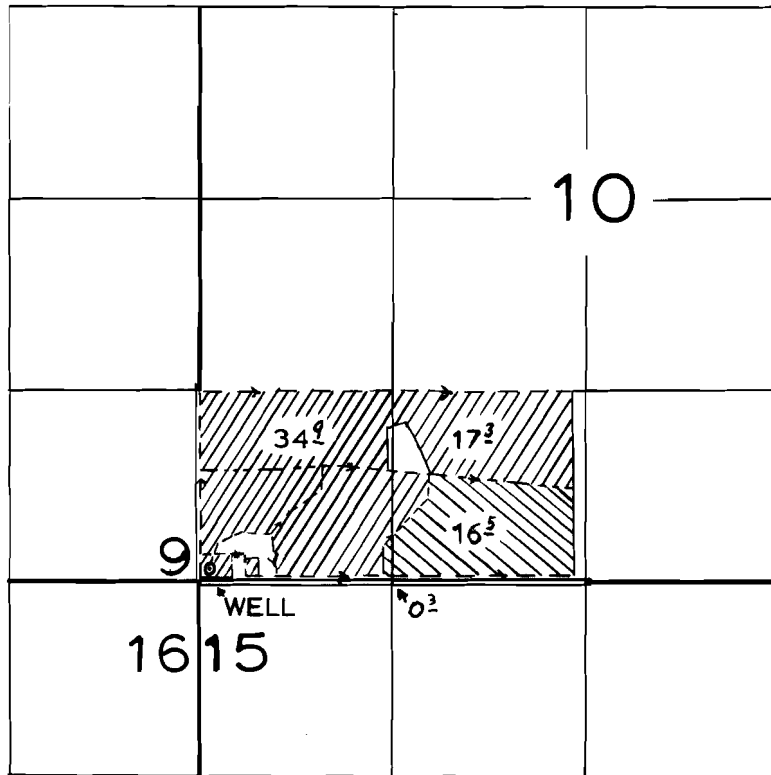

FINAL PROOF SURVEY

UNDER

PRIMARY

SUPPLEMENTAL



Application No. G-2077... Permit No. G-1908...

IN NAME OF

J. Y. MENDAZONA

Surveyed NOV. 13, 1964, by E. W. Eltering