


T.16S.R.44E.W.M.

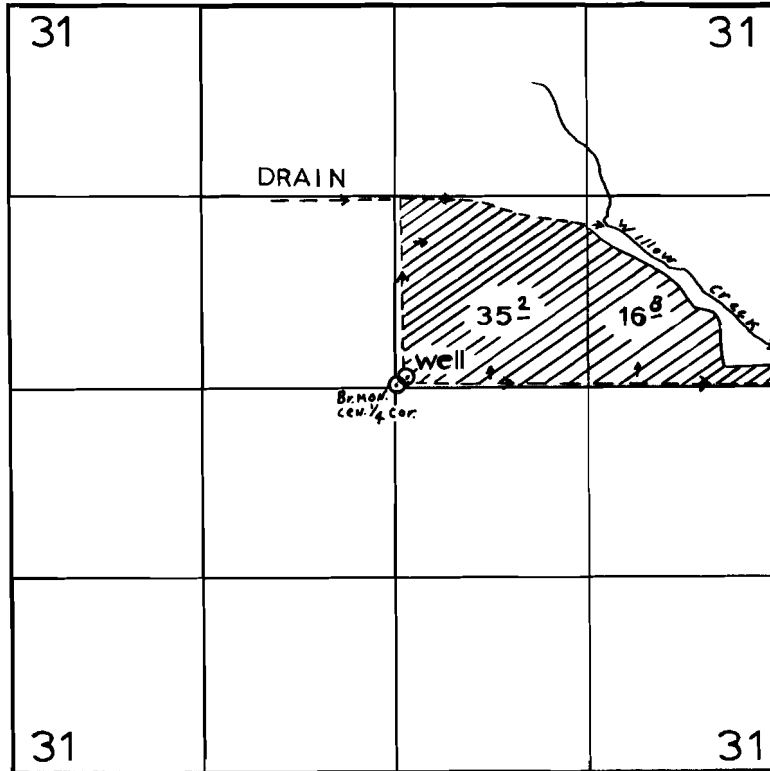

FINAL PROOF SURVEY
UNDER

Application No. G-2094 Permit No. G-1926
IN NAME OF

ALLEN LAVENDER

Surveyed MARCH 26 1964, by E. W. Effering