


T.18S.R.47E.W.M.

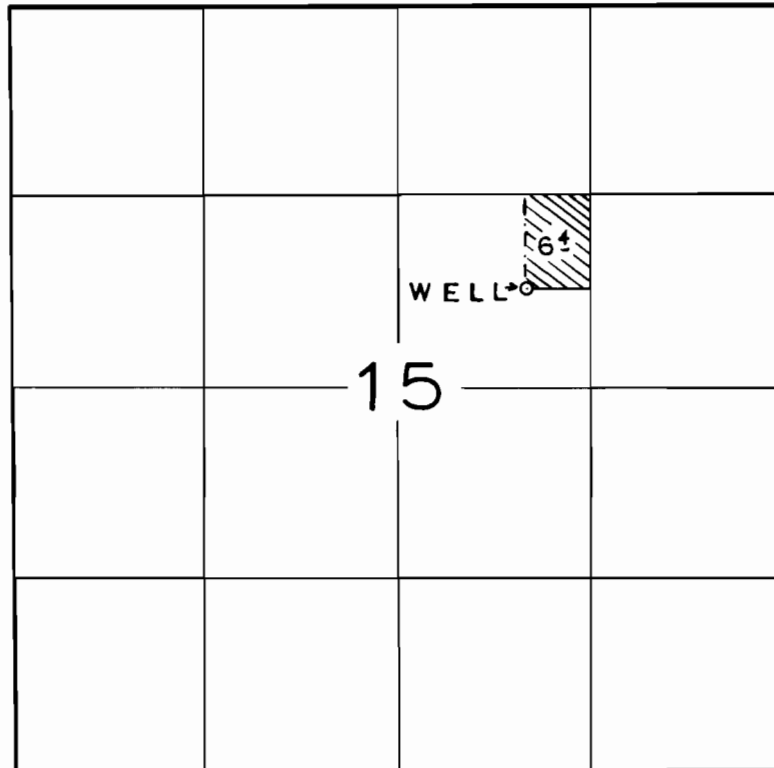

FINAL PROOF SURVEY
UNDER

Application No. G- 2285... Permit No. G- 2111.....

IN NAME OF

JOHN T. DONOVAN.....

Surveyed NOV. 23. 1964., by *E.W. Elsering*.....