


T.14S.R.39E.W.M.

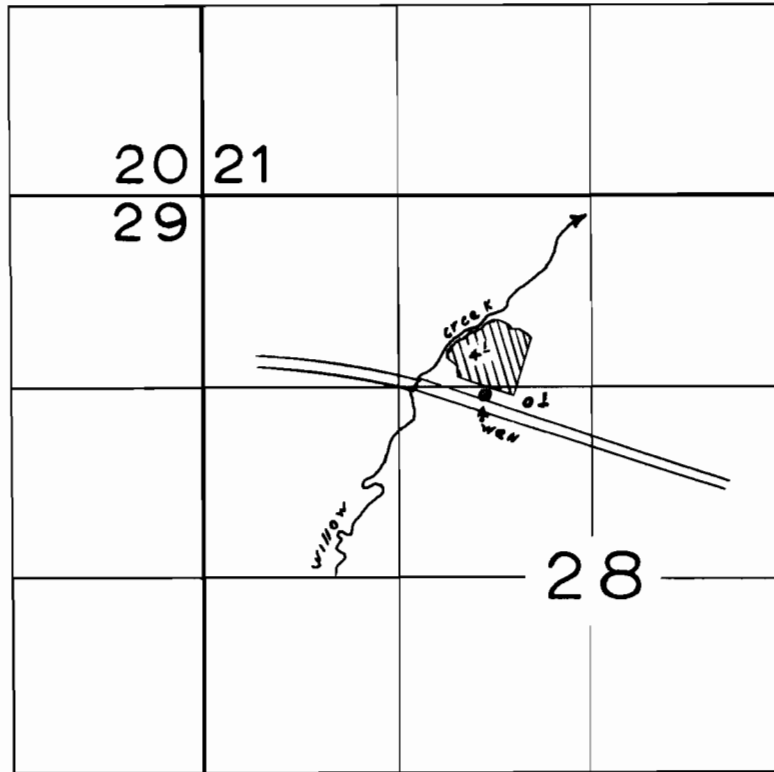

FINAL PROOF SURVEY
UNDER

Application No. G-2299... Permit No. G-2136...
IN NAME OF

CHARLES A. REDSULL

Surveyed NOV. 6, 1964, by *F.W. Elbring*.....