


T.19S.R. 41E.W. M.

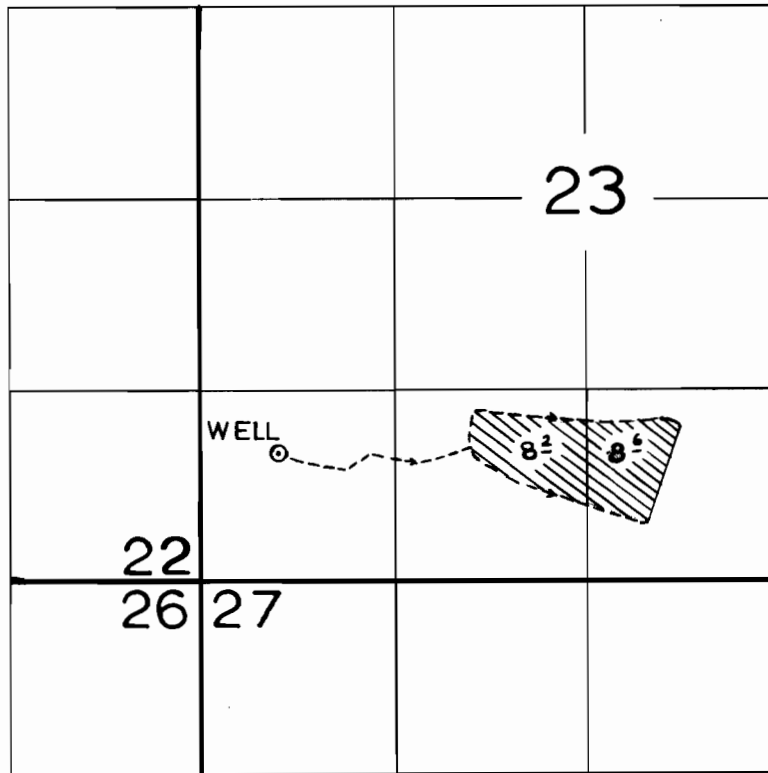

FINAL PROOF SURVEY
UNDER

Application No. G-2598 ... Permit No. G-2403
IN NAME OF

ROBERT J. HART

Surveyed OCT. 15, 1964, by E.W. Elfring