


T.20S.R. 46E.W.M.

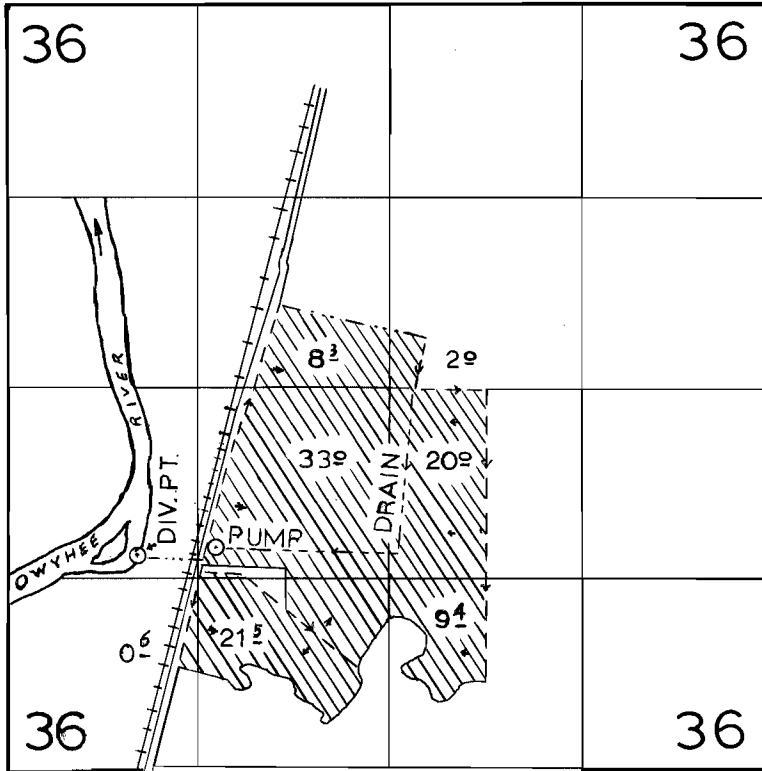

FINAL PROOF SURVEY
UNDER

Application No. 33660... Permit No. 26805...

IN NAME OF

VIRGIL W. VIERS

Surveyed NOV. 18... 1964., by *E.W. Ekering*.....