


T.18S.R.47E.W.M.

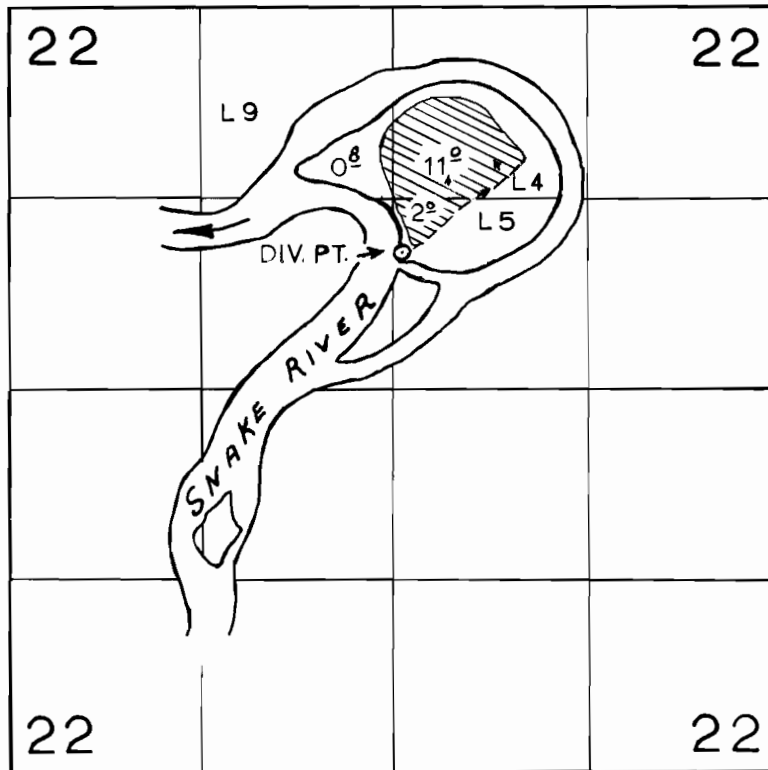

FINAL PROOF SURVEY
UNDER

Application No. 37768 Permit No. 28141
IN NAME OF

NEIL VENTURACCI

Surveyed SEPT. 15, 1964, by E.W. Elfring