


T.7S.R.3W.W.M.

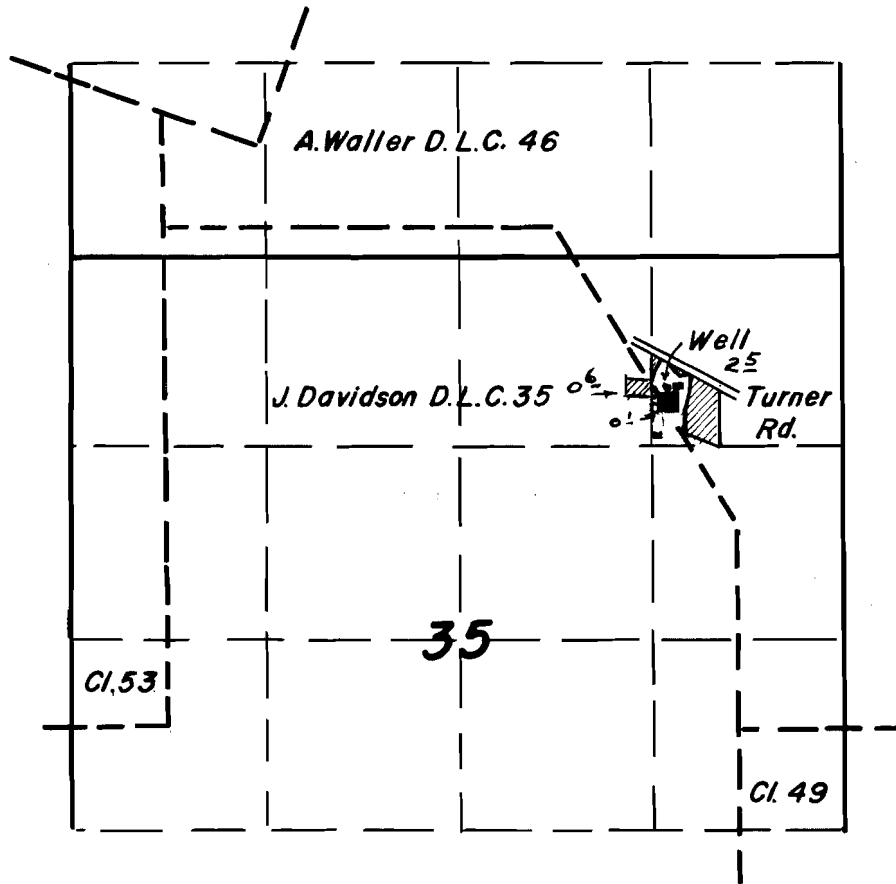

FINAL PROOF SURVEY
UNDER

Application No. *G 2133* Permit No. *G 1970*
IN NAME OF

Curly's Dairy Inc.

Surveyed *July 28 1964*, by *F. Slegmund*