


T.9 S. R. 3 W. W. M.

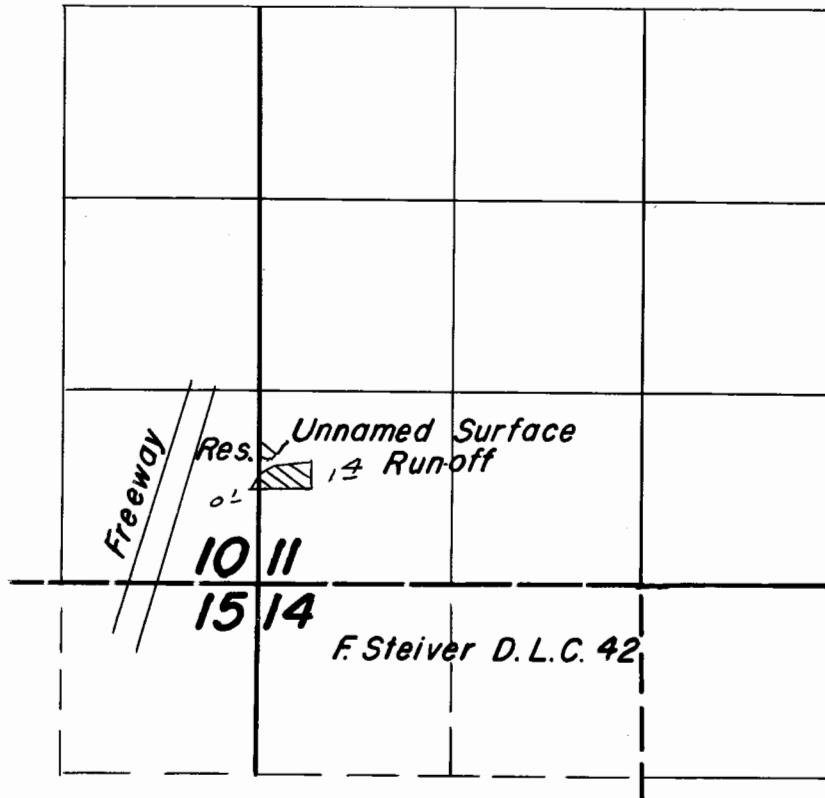

FINAL PROOF SURVEY
UNDER

Application No. ³³⁹⁴⁴ R-33943 Permit No. ²⁶⁷⁶⁰ R-2361
IN NAME OF

Frank A. Slick

Surveyed *Nov. 16, 1964*, by *F. Siegmund*