


T.9 S. R. 3 W. W. M.

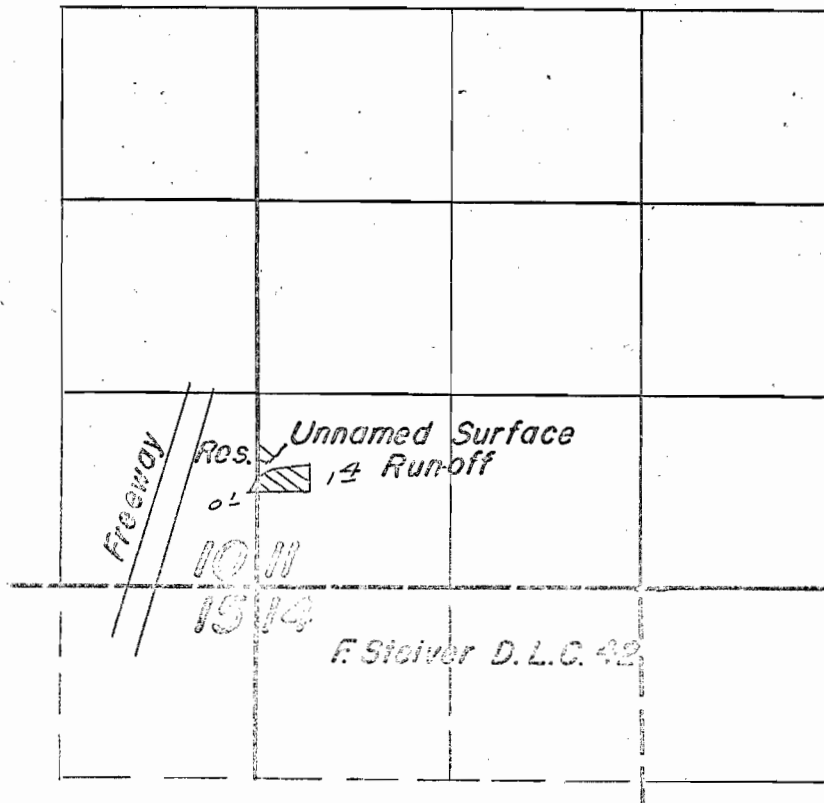

FINAL PROOF SURVEY
UNDER

Application No. *33944* Permit No. *26760*
R. 33943 Permit No. *R. 2361*

IN NAME OF

Frank A. Slick

Surveyed *Nov. 16* 1964, by *F. Slegmund*