


T. 4 S. R. 1 & 2 W. W. M.

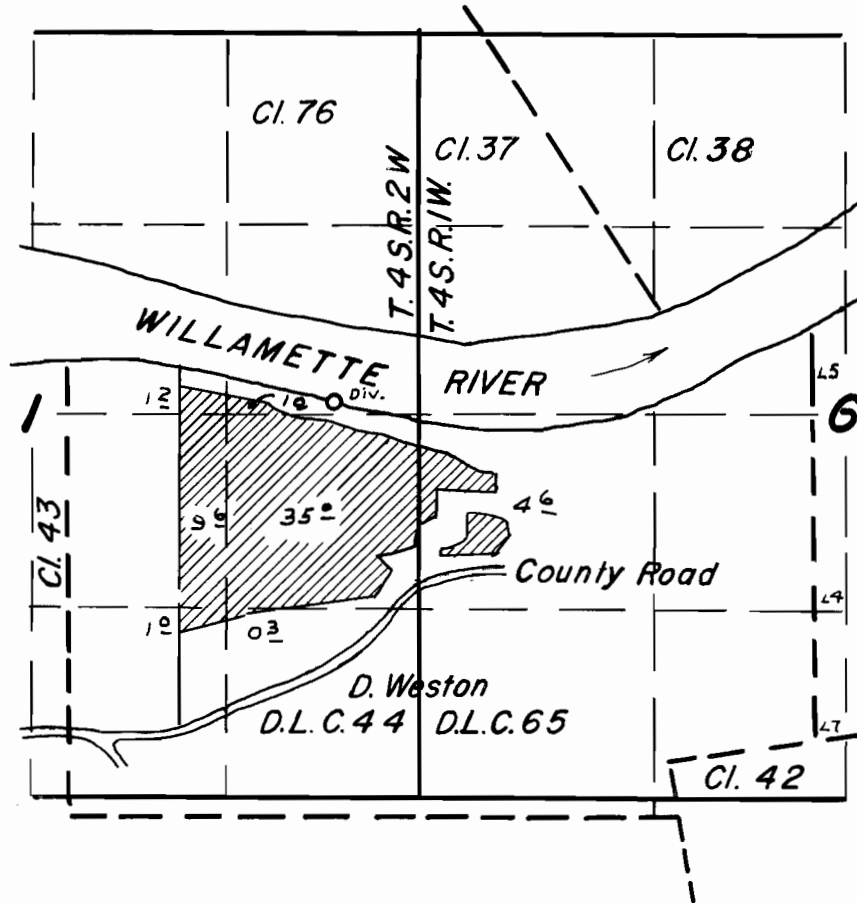

FINAL PROOF SURVEY  
UNDER

Application No. 34,572... Permit No. 27152  
IN NAME OF

**Miles Sulak**

Surveyed Oct. 5, 1964, by F. Siegmund.