


T.I.N.R.I.E.W.M.

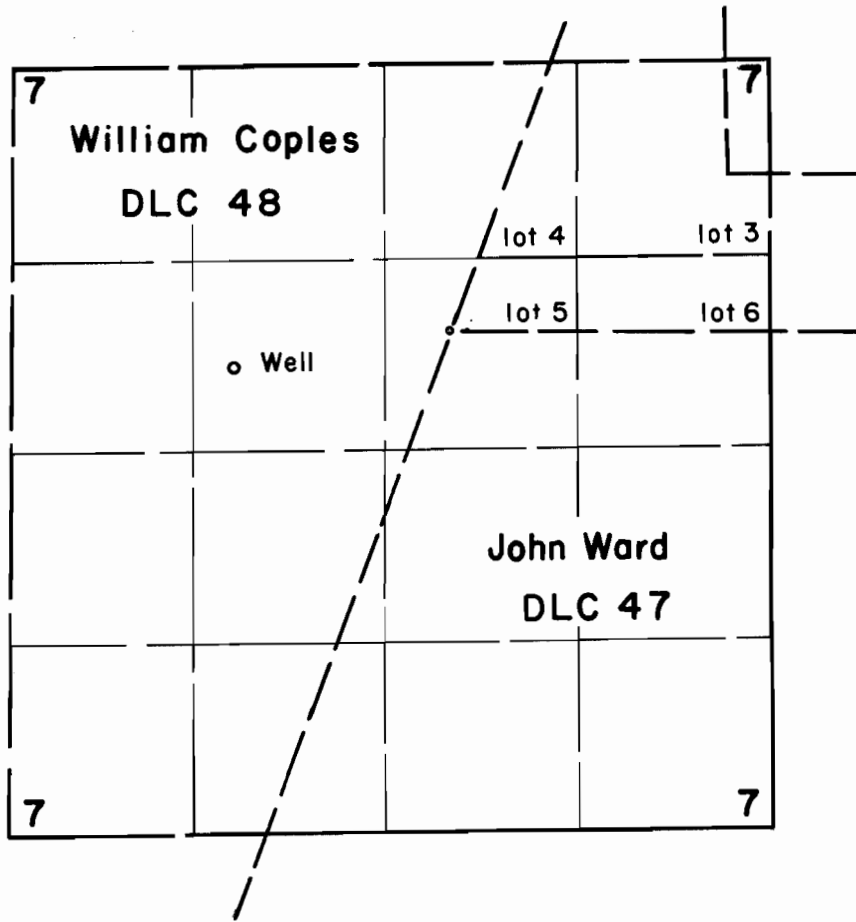

FINAL PROOF SURVEY UNDER

Application No. G-2415... Permit No. G-2233...
IN NAME OF

Fred Meyer Inc.

Surveyed July 29 1963, by Tom Lauer