


T.6S.R.10W.W.M.

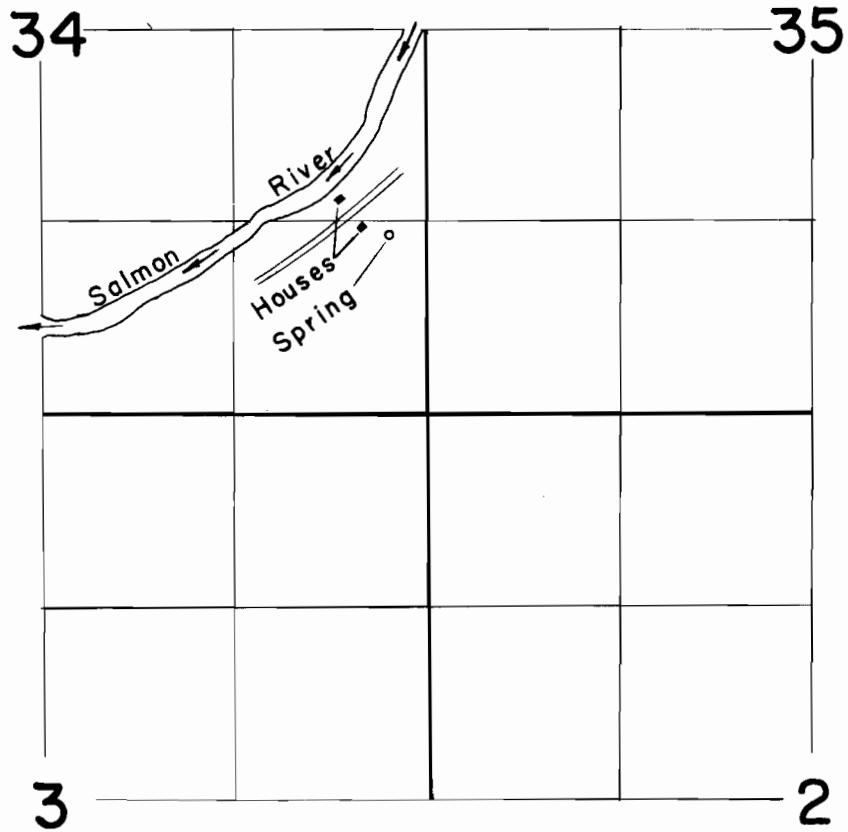

FINAL PROOF SURVEY
UNDER

Application No. 38762 Permit No. 28994
IN NAME OF

Lee E. & Ruth B. Gibson

Surveyed Sept. 20 1964, by F. Siegmund