


T.3N.R.28E.W.M.

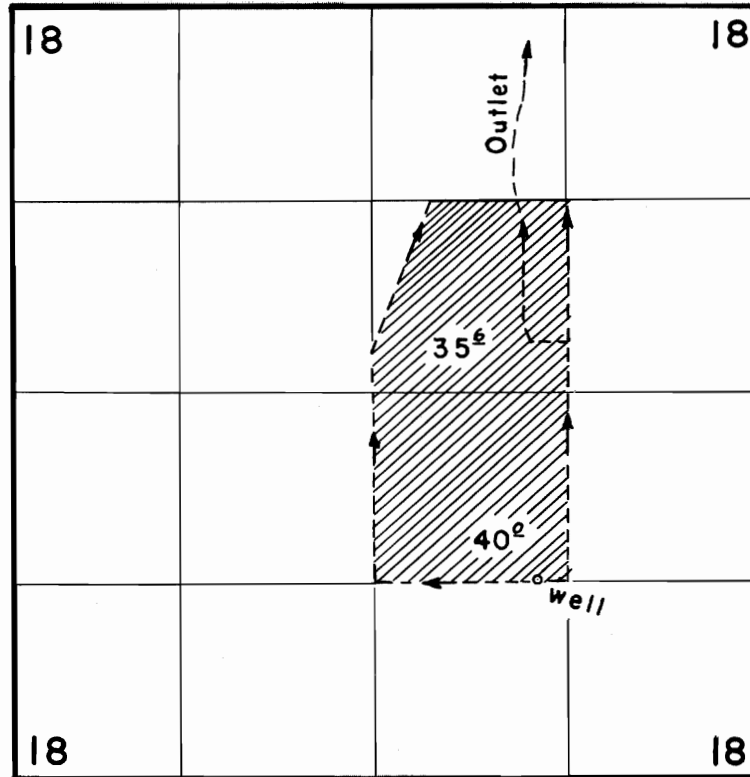

**FINAL PROOF SURVEY**  
UNDER

Application No. G-1836 Permit No. G-1685  
IN NAME OF

Harry J. Andrews

Surveyed Aug. 20, 1964, by G.J. Gardner