


T.6N.R.35E.W.M.

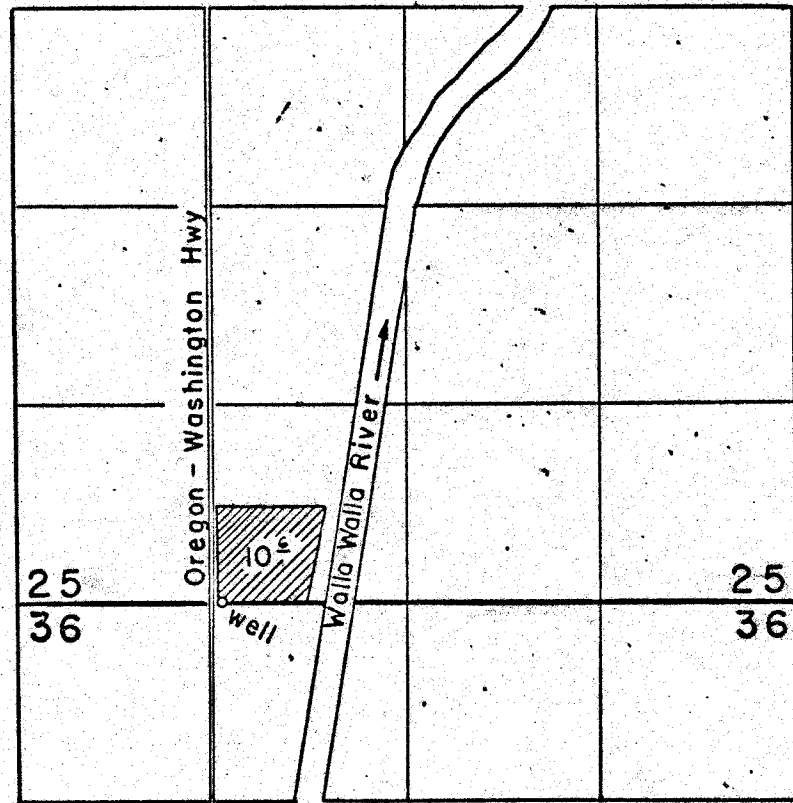

FINAL PROOF SURVEY UNDER

Application No. G-2713... Permit No. G-2545
IN NAME OF

.....John H. McMunn.....

Surveyed Aug. 25 1964, by C.J. Gardner.....