


T.2N.R.30E.W.M.

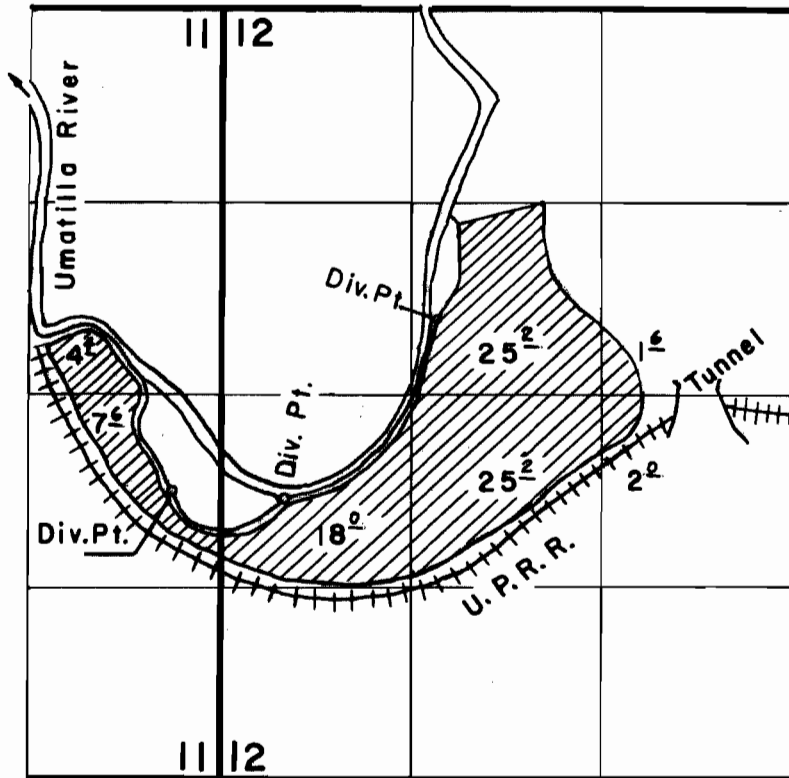

FINAL PROOF SURVEY UNDER

Application No. 33006. Permit No. 26122.
IN NAME OF

..... Lewis Livestock Co. Inc.

Surveyed Aug. 21. 1964, by C.J. Gardner.