


Map OF East Beaver Cheese Company's Water Right


Map No. 7275
Section No. 4600

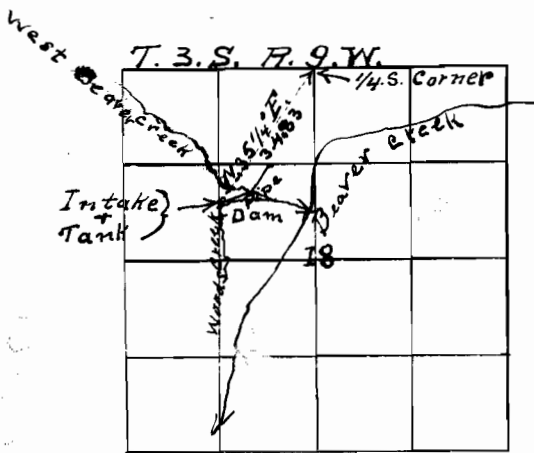

Field Notes of Pipe Line

Beginning at the tank or intake
Thence N. 69 3/4° E. 6.90 chains

" N. 71.3 2 1/2° E. 5.93 " To the factory.

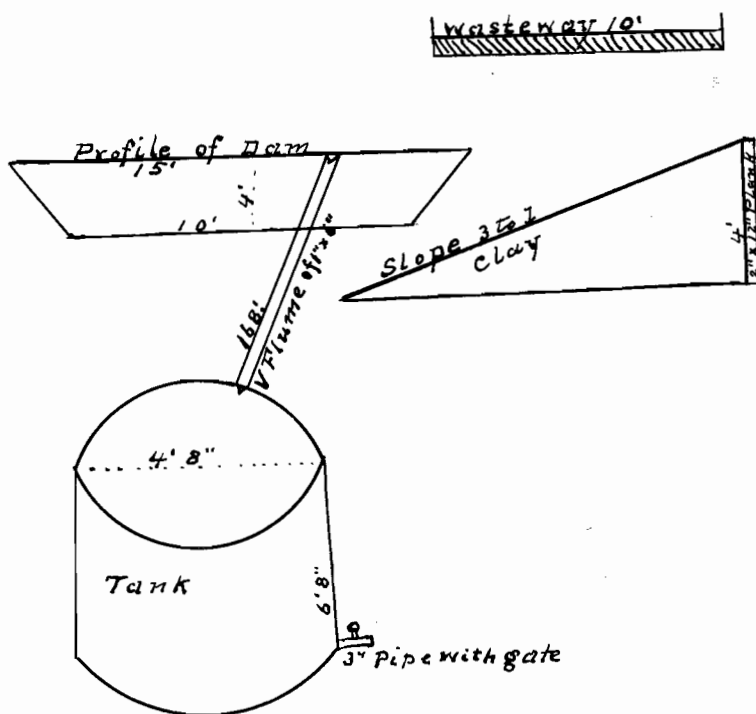

CERTIFICATE OF SURVEYOR

I, A. M. AUSTIN, of TILLAMOOK COUNTY, OREGON, do hereby certify that this map was made from notes taken during an actual survey made by me (or under my immediate supervision) on

April 19th , 1920, and that it correctly represents the works described in the accompanying application, together with the location of streams and other ditches in the immediate vicinity, and has written thereon the area in each smallest legal subdivision which it is proposed to irrigate.

A. M. Austin

-Surveyor-