


T.6N.R.36E.W.M.

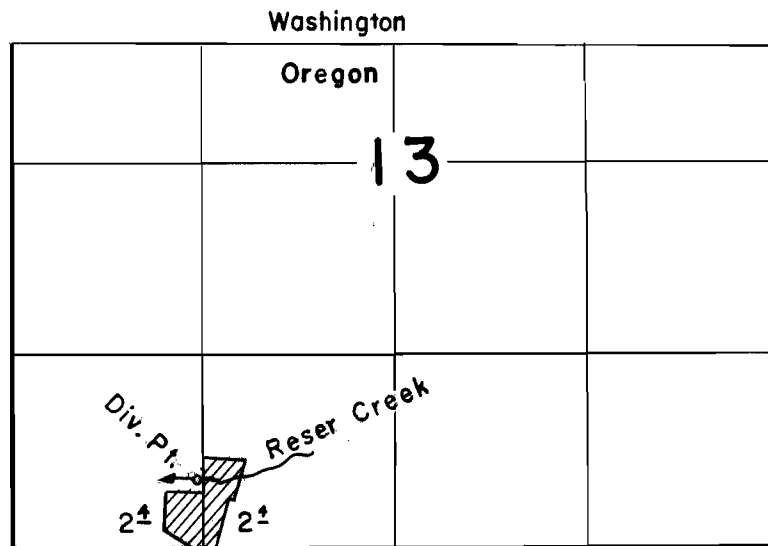

FINAL PROOF SURVEY
UNDER

Application No. 37109 Permit No. 27658
IN NAME OF

Raymond Reser

Surveyed Aug. 25 1965, by C.J. Gardner