


T.6S.R.41E.W.M.

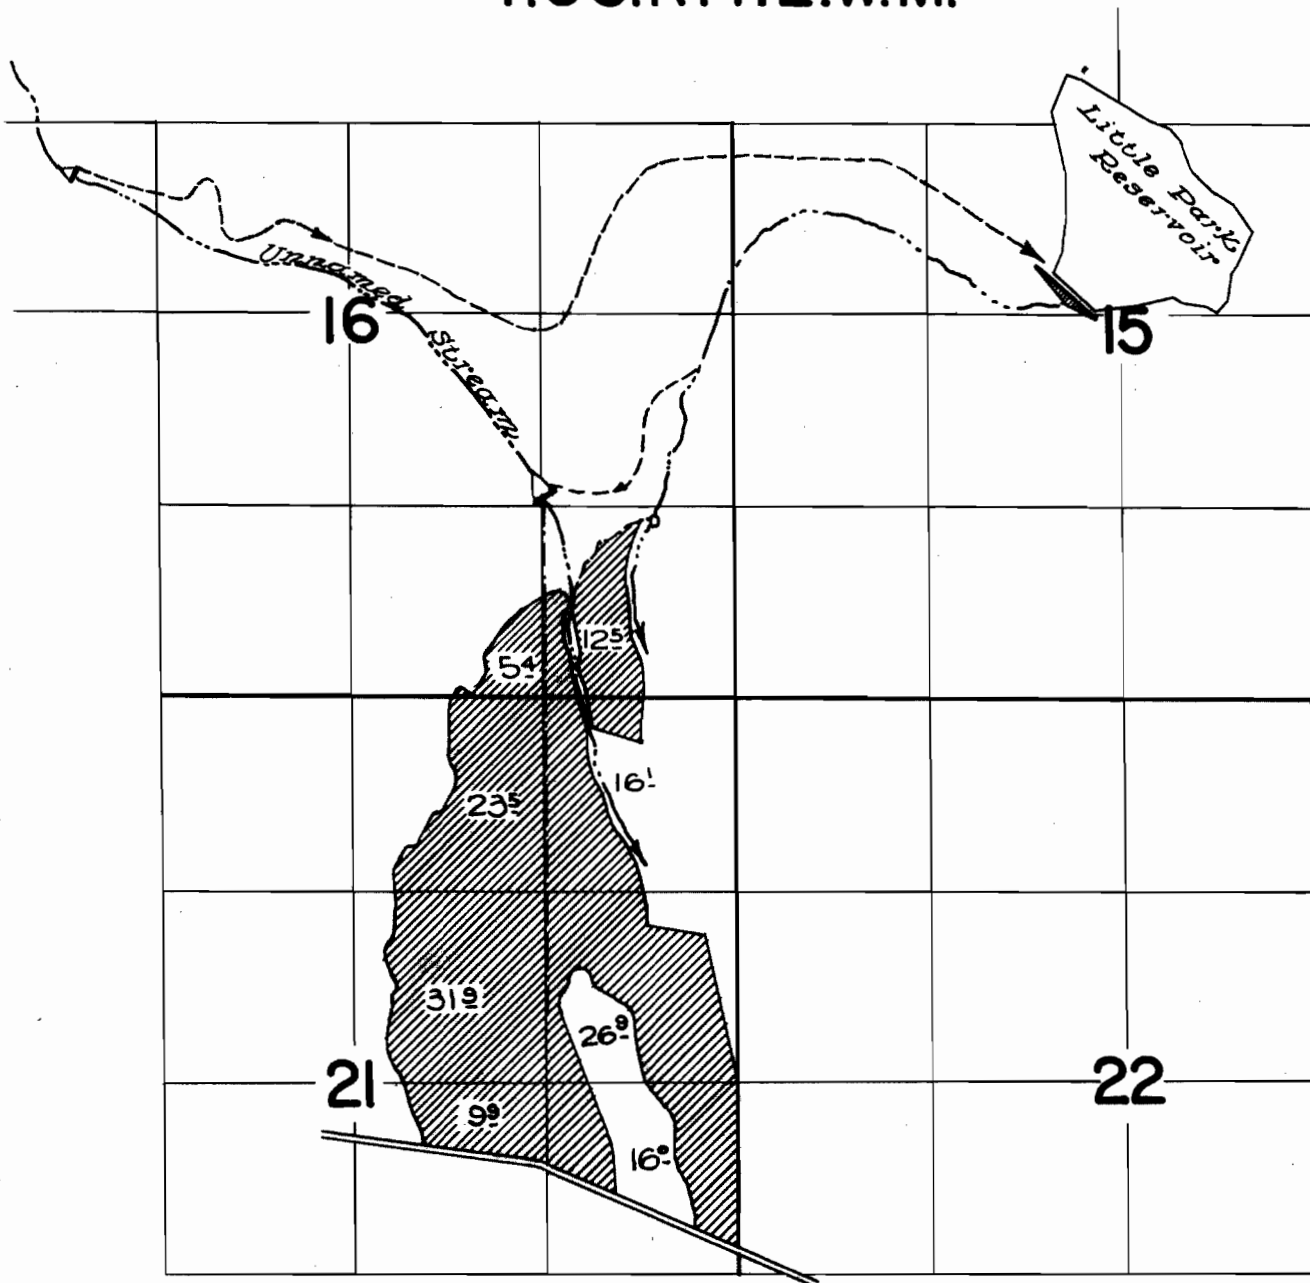

FINAL PROOF SURVEY

UNDER

R-33177

R-2255

33176

26241

R-31264

R-2034

Application No. **31265** Permit No. **24954**

IN NAME OF

WILBUR E. & GENEVA FISK

Surveyed Oct. 2, 1963, by T. Lauer

RL