


T.G.S.R.41E.W.M.

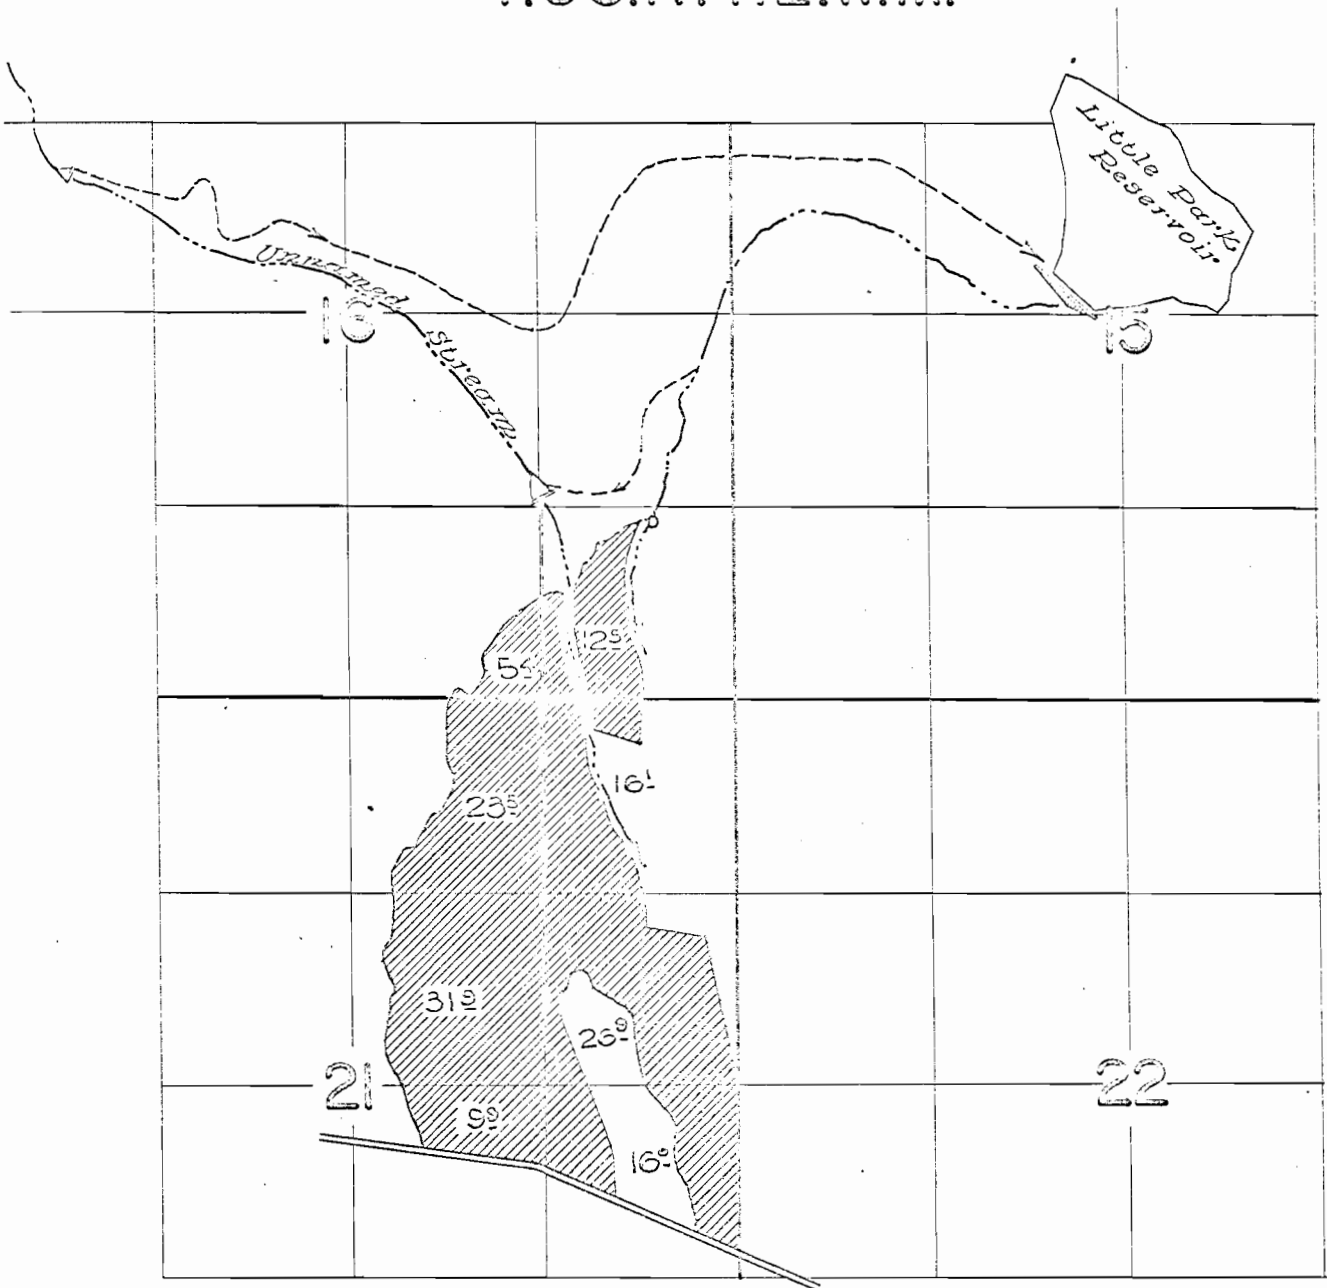

FINAL PROOF SURVEY

UNDER

R-33177
33176
R-31204

R-2255
23241
R-2034

Application No. 31208 Permit No. 24034

IN NAME OF

WILBUR E. & GENEVA FISK

Surveyed Oct. 2, 1963, by T. Lauer.