


T. I. S. R. 39 E. W. M.

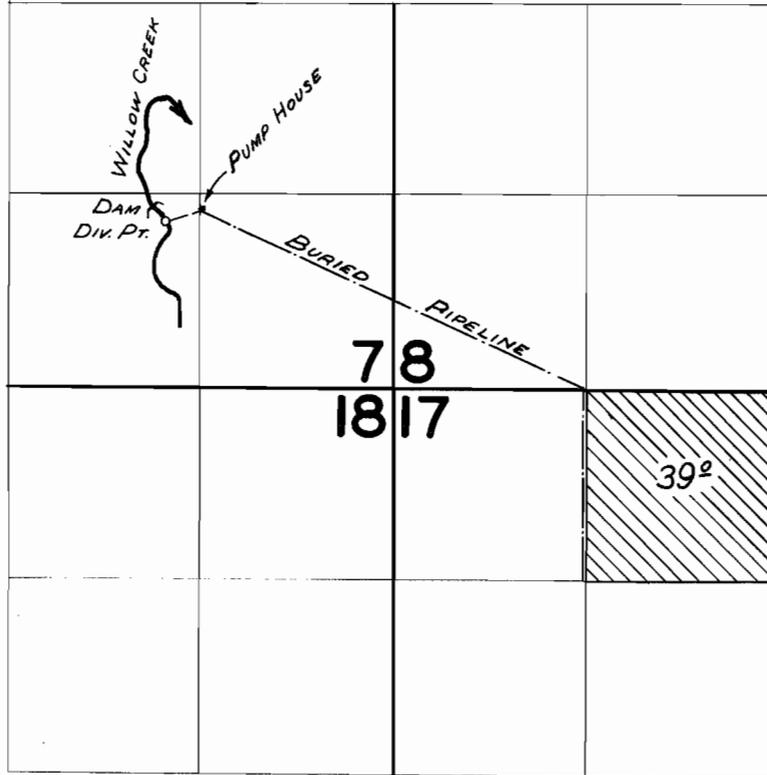

FINAL PROOF SURVEY UNDER

Application No. 33636 Permit No. 26590
IN NAME OF

GEORGE & ELIZABETH ROYES

Surveyed SEP. 25 1963, by T. LAUER