


T. 15. R. 39 E. W. M.

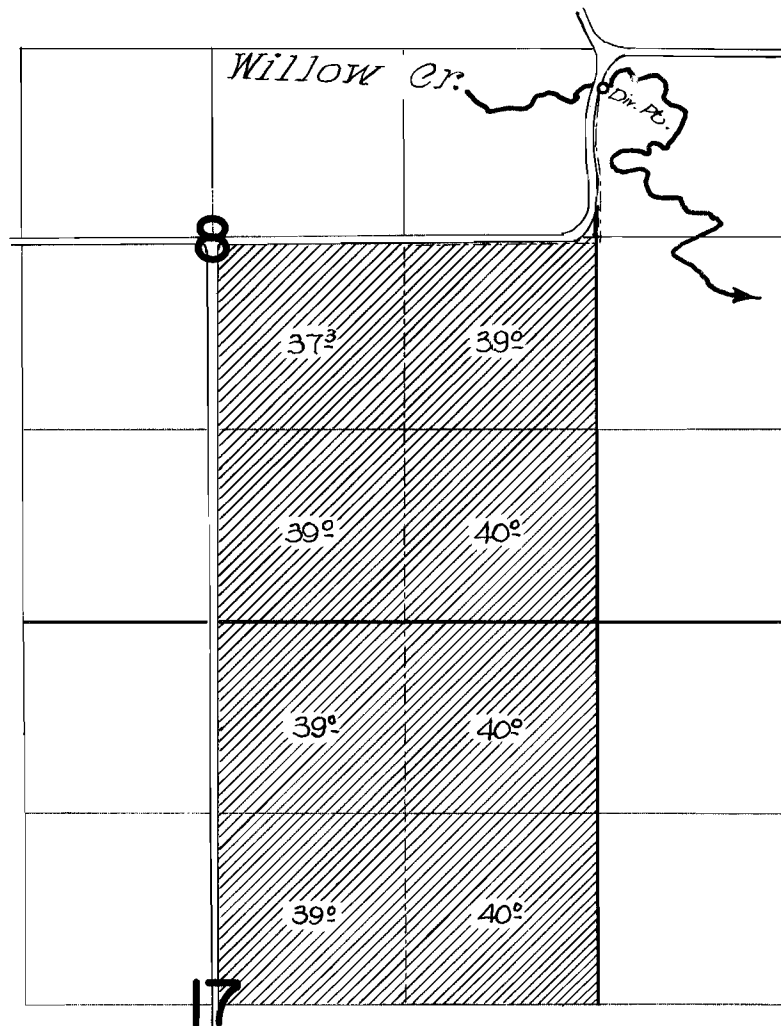

FINAL PROOF SURVEY UNDER

Application No. **33637** Permit No. **26591**
IN NAME OF

GEORGE & ELIZABETH ROYES

Surveyed Sept. 25 1963, by *T. Lauer*