


T. I. S. R. 39 E. W. M.

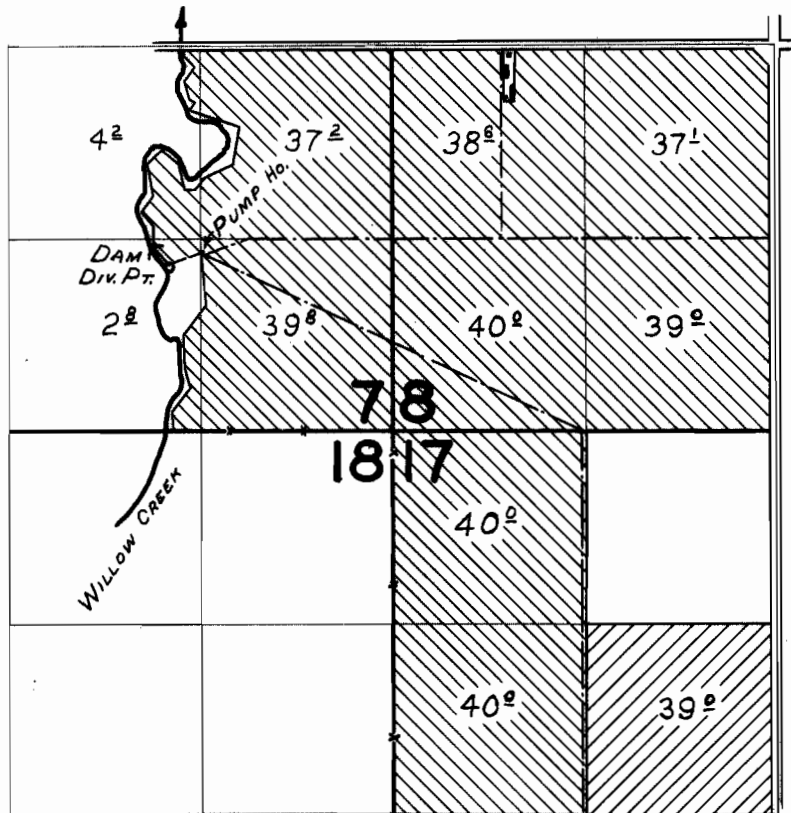

PRIMARY



FOR ADDITIONAL WATER

FINAL PROOF SURVEY UNDER

Application No. 37320 Permit No. 27800
IN NAME OF

GEORGE & ELIZABETH ROYES

Surveyed SEP 25 1963, by T. LAUER