


T.2S.R.39E.W.M.

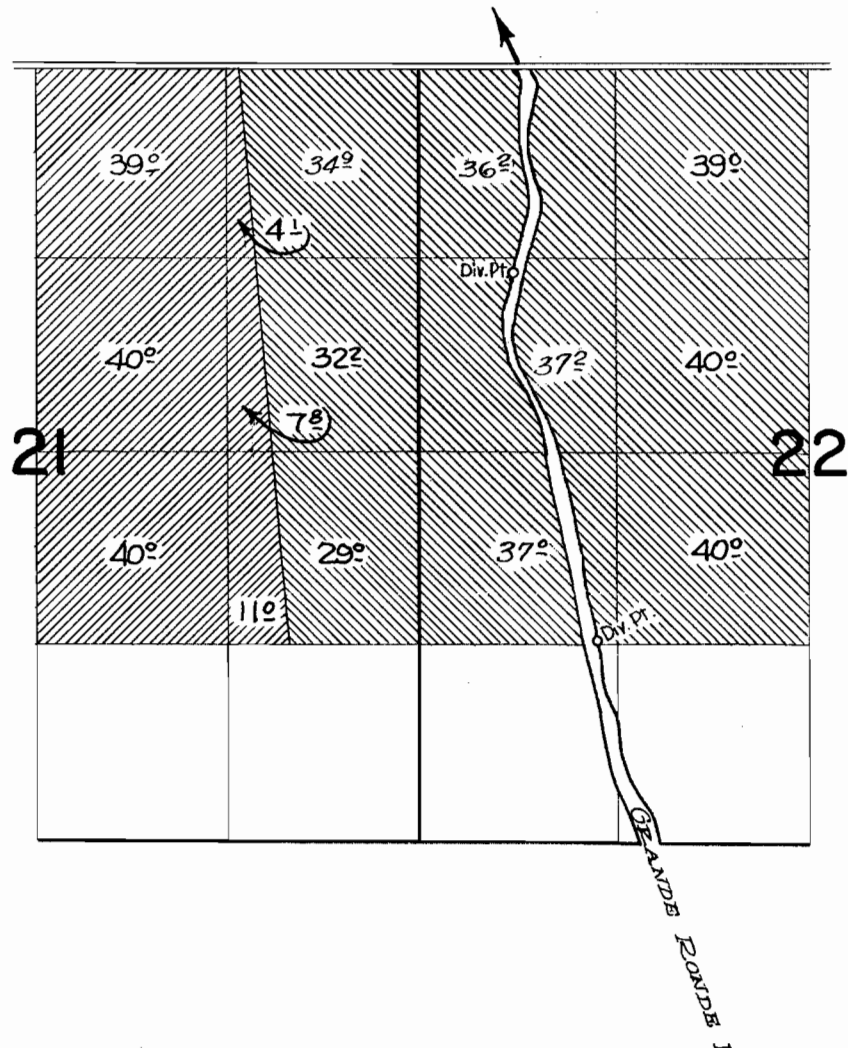

FINAL PROOF SURVEY
UNDER

Application No. 34751 27281
37322 Permit No. 27802
IN NAME OF

SYLVAN B. & MARTHA JOY RASMUSSEN

Surveyed Oct. 3, 1963, by T. Lauer