


T. 15. R. 39 E. W. M.

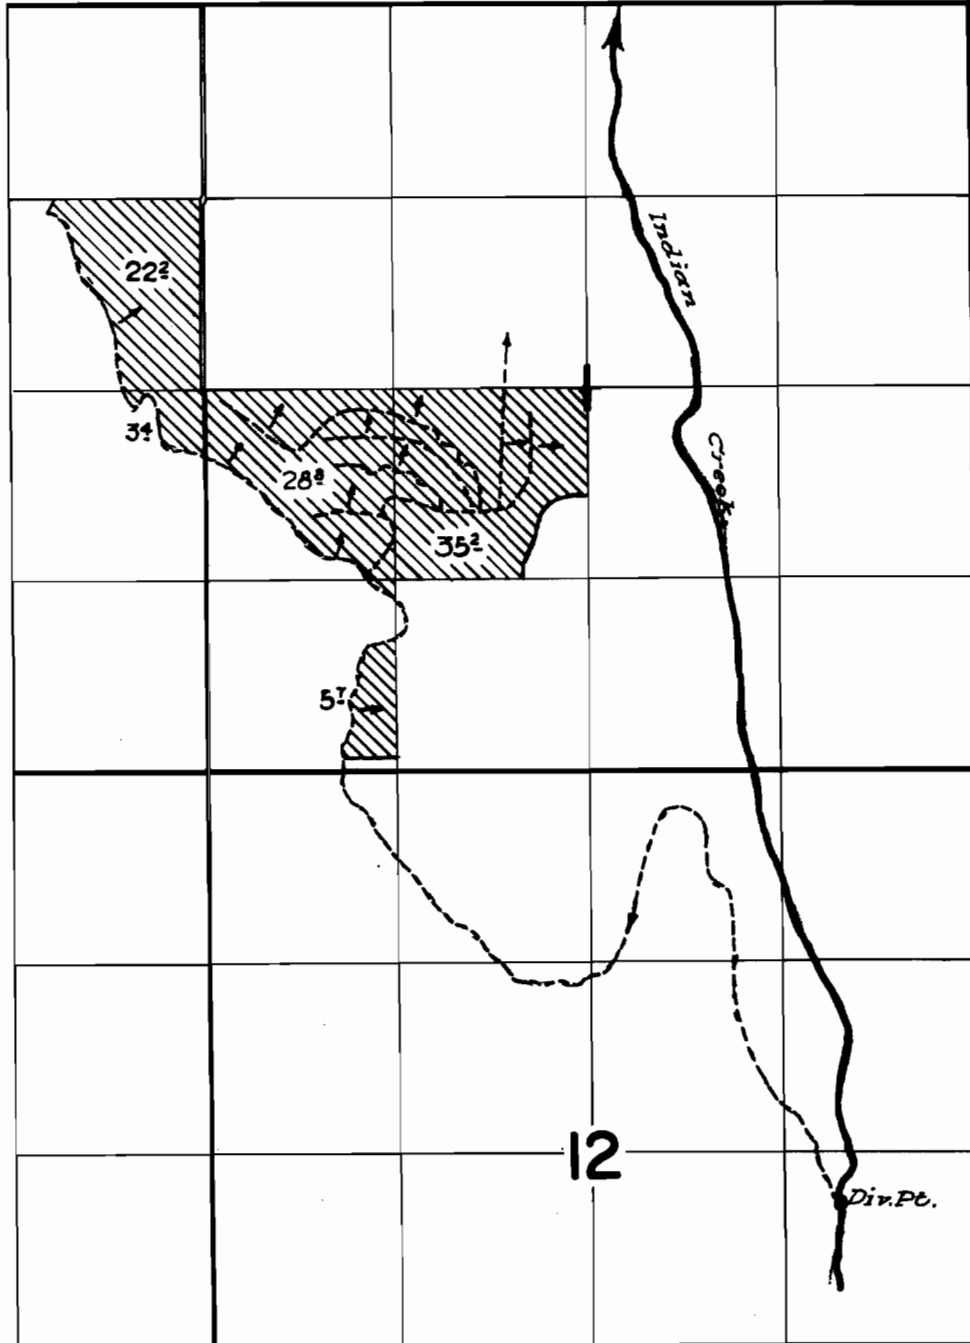


FINAL PROOF SURVEY UNDER

Application No. **29524**... Permit No. **23248**..
IN NAME OF

MILON & NELLIE B. LINDSAY

Surveyed Aug. 5, 1959, by *Al Johnson*

T.I.S.R. 39E.W.M.

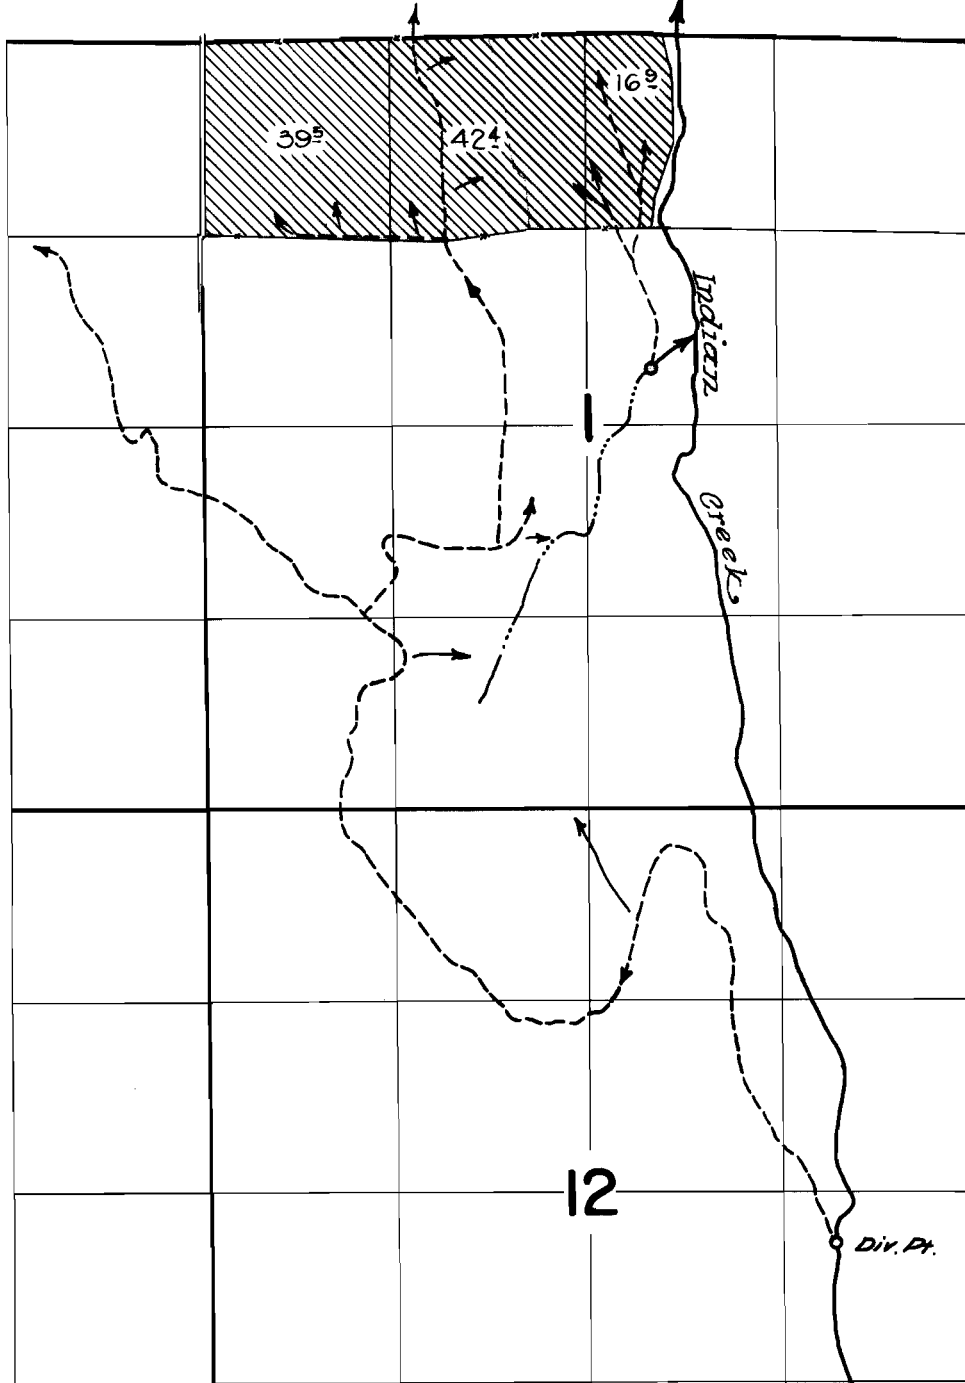

FINAL PROOF SURVEY
UNDER

Application No. 29524 Permit No. 23248
IN NAME OF

EARL & GENEVA TARBELL

Surveyed Aug. 5 1959, by *T. Lauer*
Sept. 25 63 T. Lauer