


TOWNSHIP 34 S., RANGE 1 W.

8-4-4

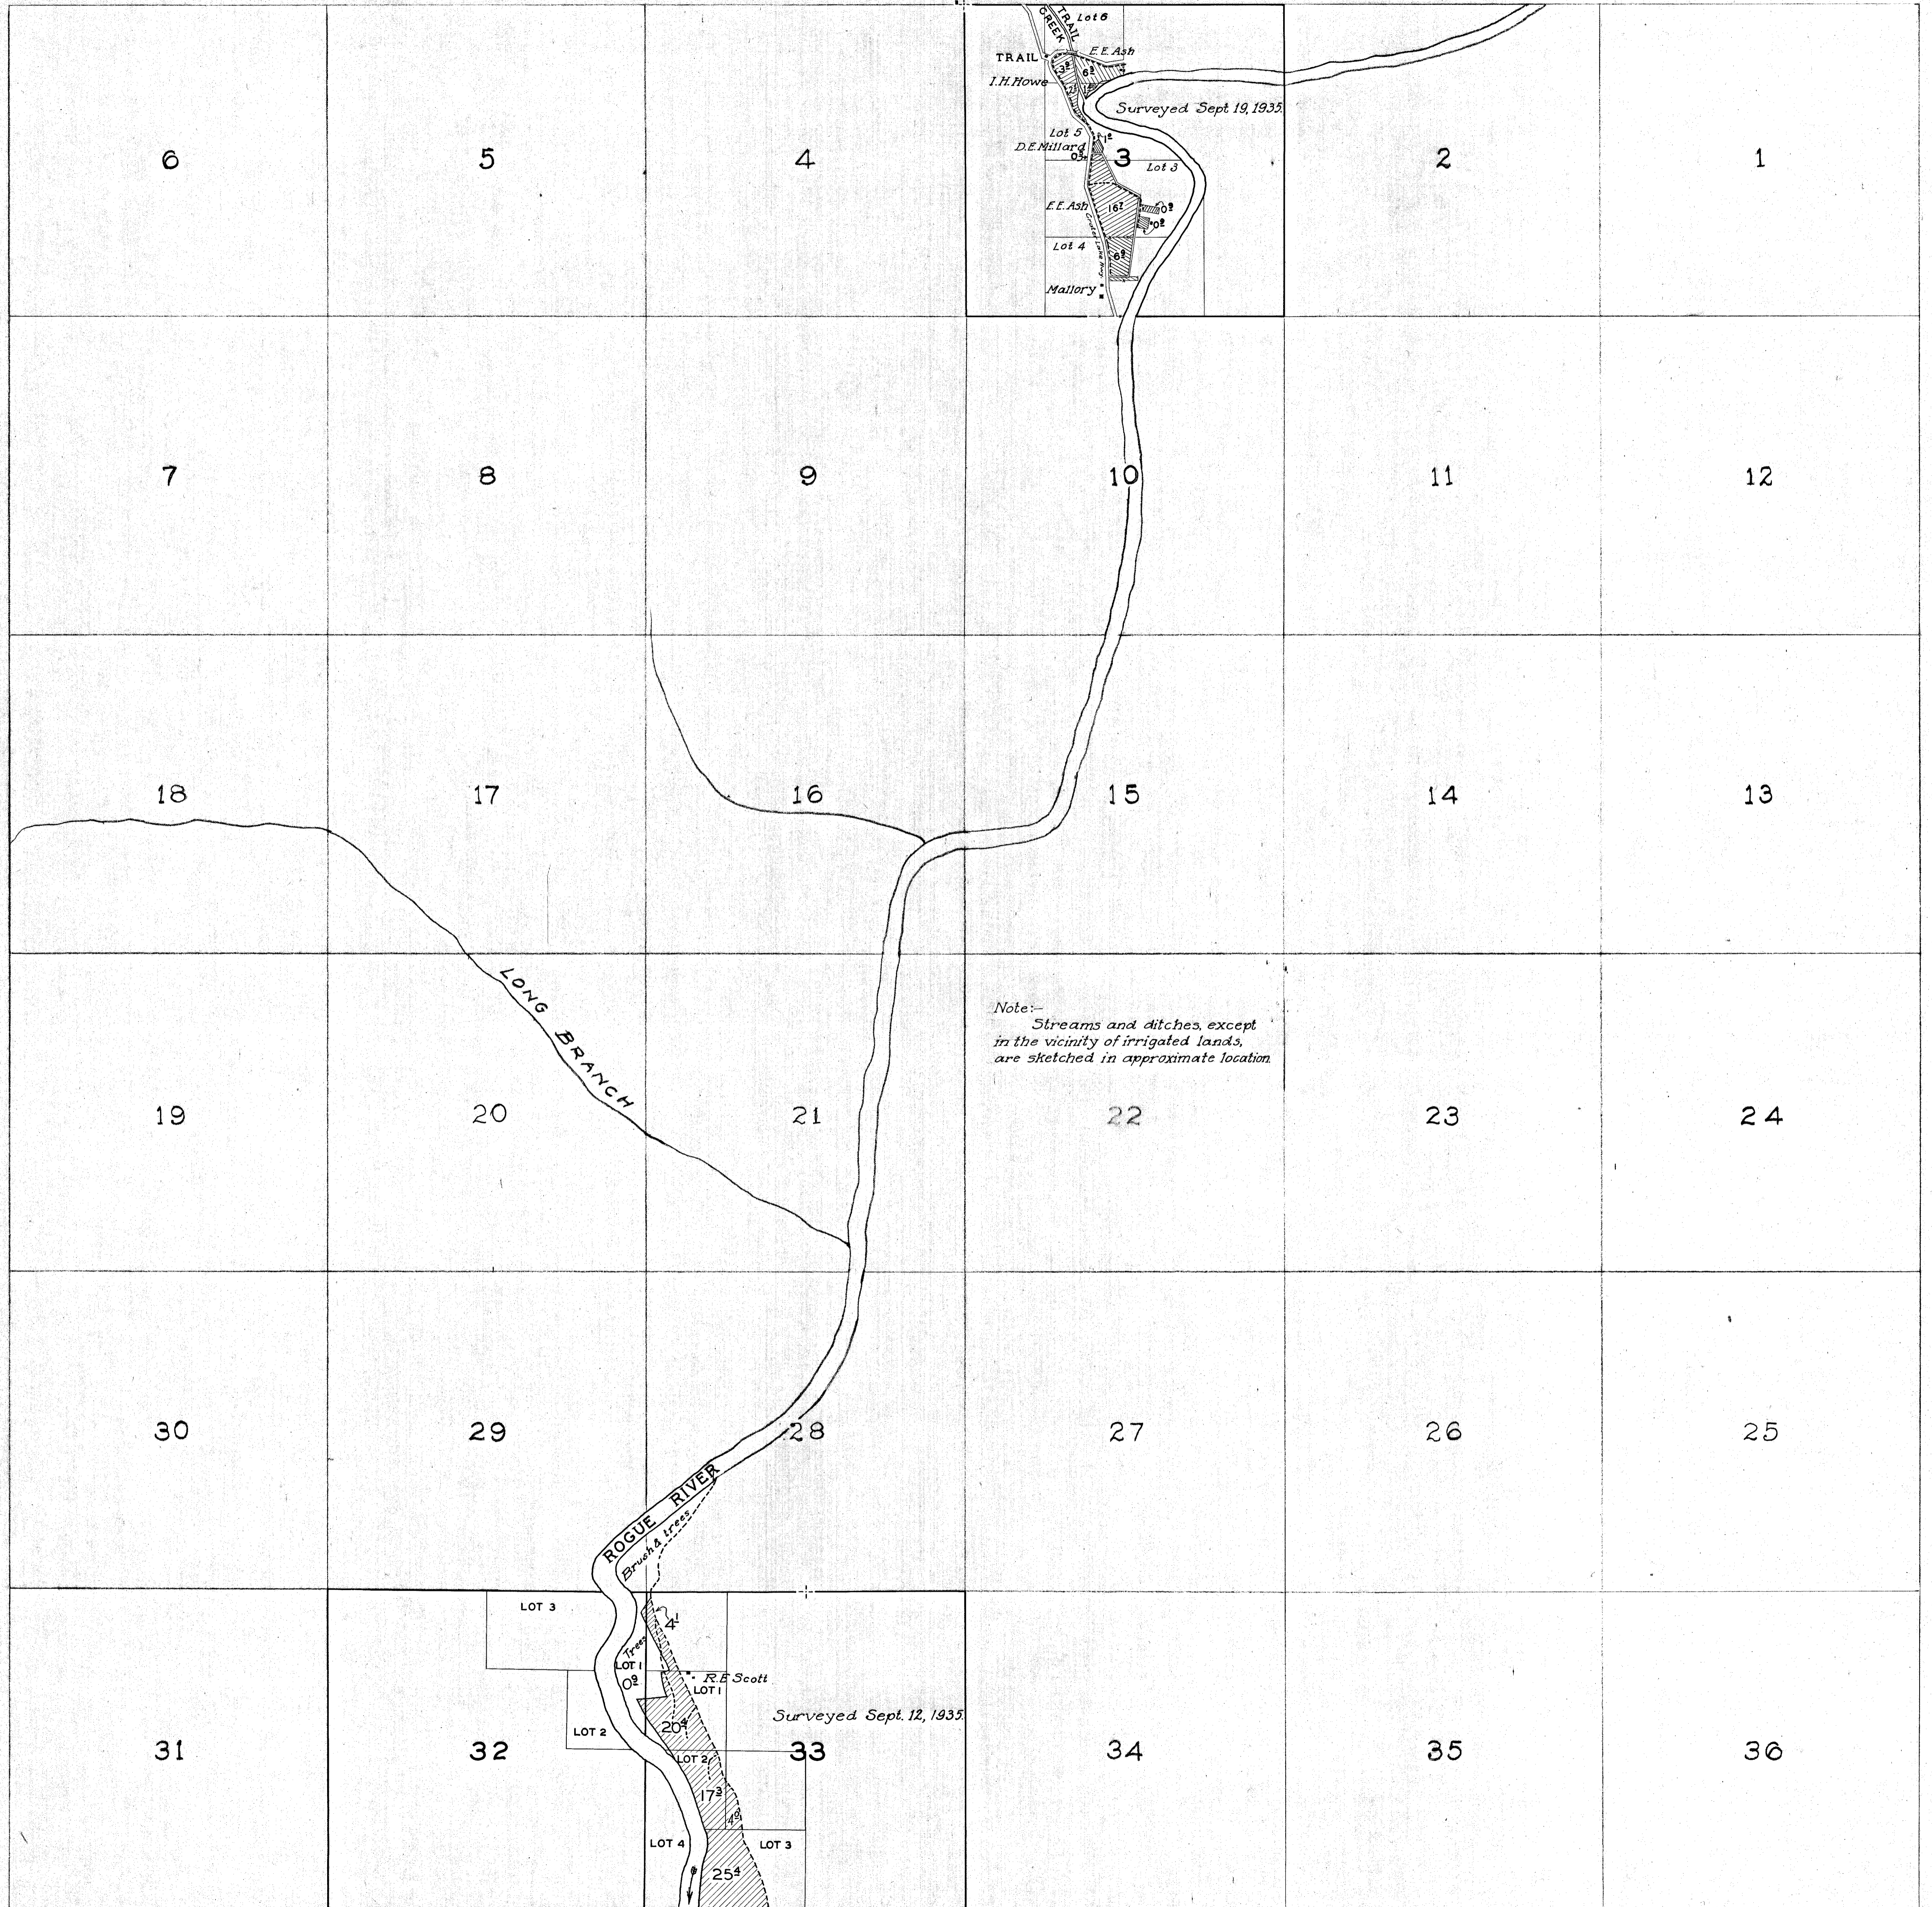

Note:-
Streams and ditches, except
in the vicinity of irrigated lands,
are sketched in approximate location.